


**PROPERTY LINE ADJUSTMENT  
FOR BOYD RUBY**  
IN THE NW 1/4 OF SEC 3 T4N, R4W, W.M.  
COLUMBIA COUNTY, OREGON  
SCALE 1" = 50'      AUG 14, 1995

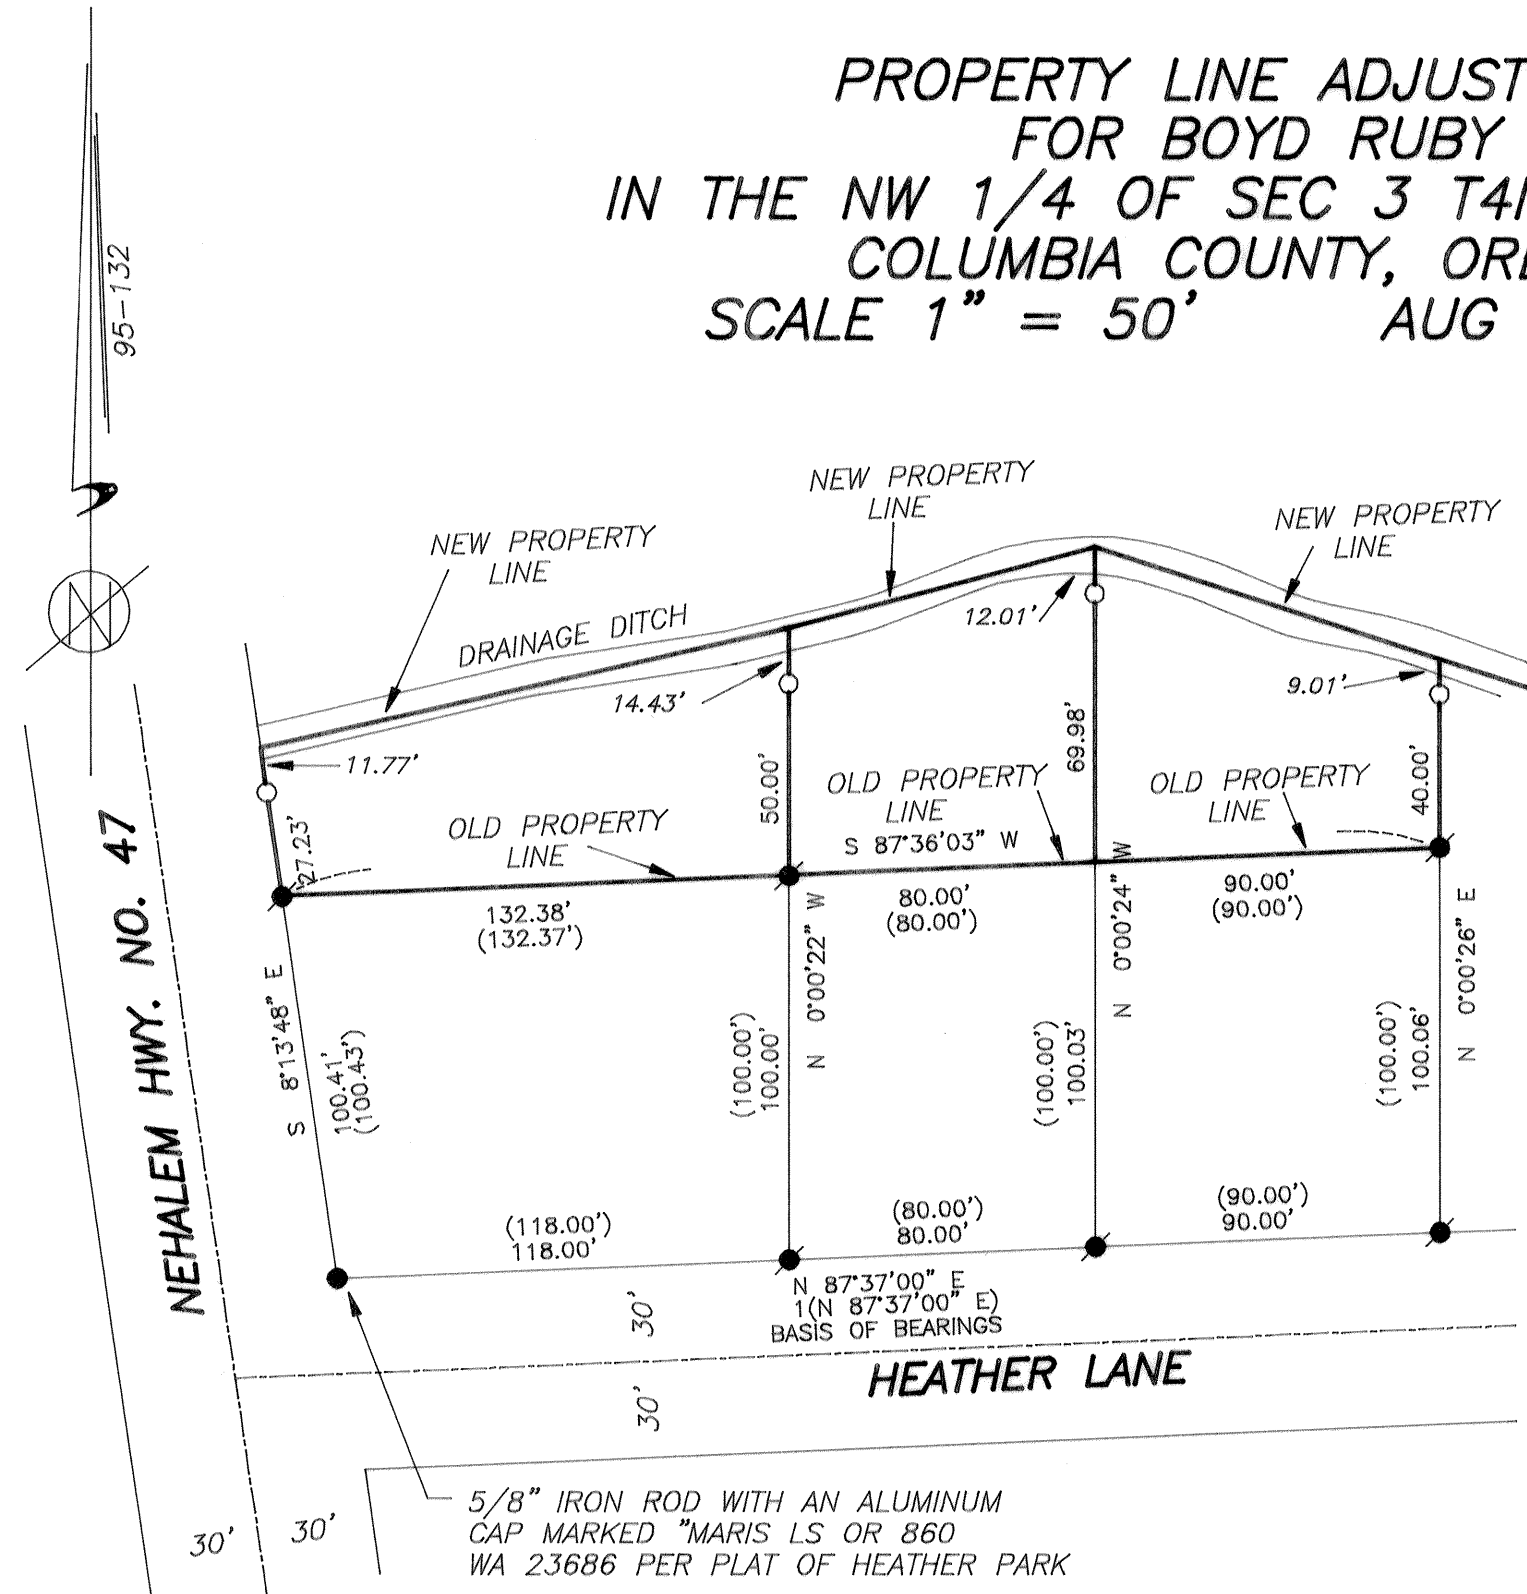

**NARRATIVE:**

THIS SURVEY WAS ACCOMPLISHED AT THE REQUEST OF BOYD RUBY TO MONUMENT A PROPERTY LINE ADJUSTMENT AS SHOWN. THE BASIS OF BEARINGS IS FROM CS No. 3357. THE OLD PROPERTY LINES WERE EXTENDED TO THE CENTER OF THE DRAINAGE DITCH AS SHOWN.

**LEGEND**

● = A 5/8" IRON ROD WITH A Y.P.C. MARKED "LS 847" PER CS No. 3357

○ = SET A 5/8" X 30" IRON ROD WITH A Y.P.C. MARKED "KEENON LAND SERVICES INC."

( ) = RECORD DEED DATA  
1 = CS No. 3357

CS = RECORD SURVEY NO.

Y.P.C. = YELLOW PLASTIC CAP

● = MONUMENT FOUND AS NOTED

REGISTERED  
PROFESSIONAL  
LAND SURVEYOR

*Leslie G. Keenon*

OREGON  
JULY 30, 1976  
LESLIE G. KEENON  
1080

RENEWAL DATE 6/30/97

LAND  
SERVICES  
KEENON  
1224 ALDER ST.  
VERNONIA, OR  
97064  
(503) 429-6115

COLUMBIA COUNTY SURVEYORS OFFICE  
RECIEVED 10/26/95

ACCEPTED FOR FILING 2-7-96  
CH # 4282