


RECORD OF SURVEY
FOR CHARLES DAVIS AND SAM CEBALLOS
IN THE NW 1/4 OF SEC. 4, T4N, R4W, WM.
LOTS 1-2 BLK 1 AND LOTS 2-5 BLK 3
EAST SIDE ADD. TO VERNONIA
COLUMBIA COUNTY, OREGON
SCALE 1"=200' SEPT 6, 1993

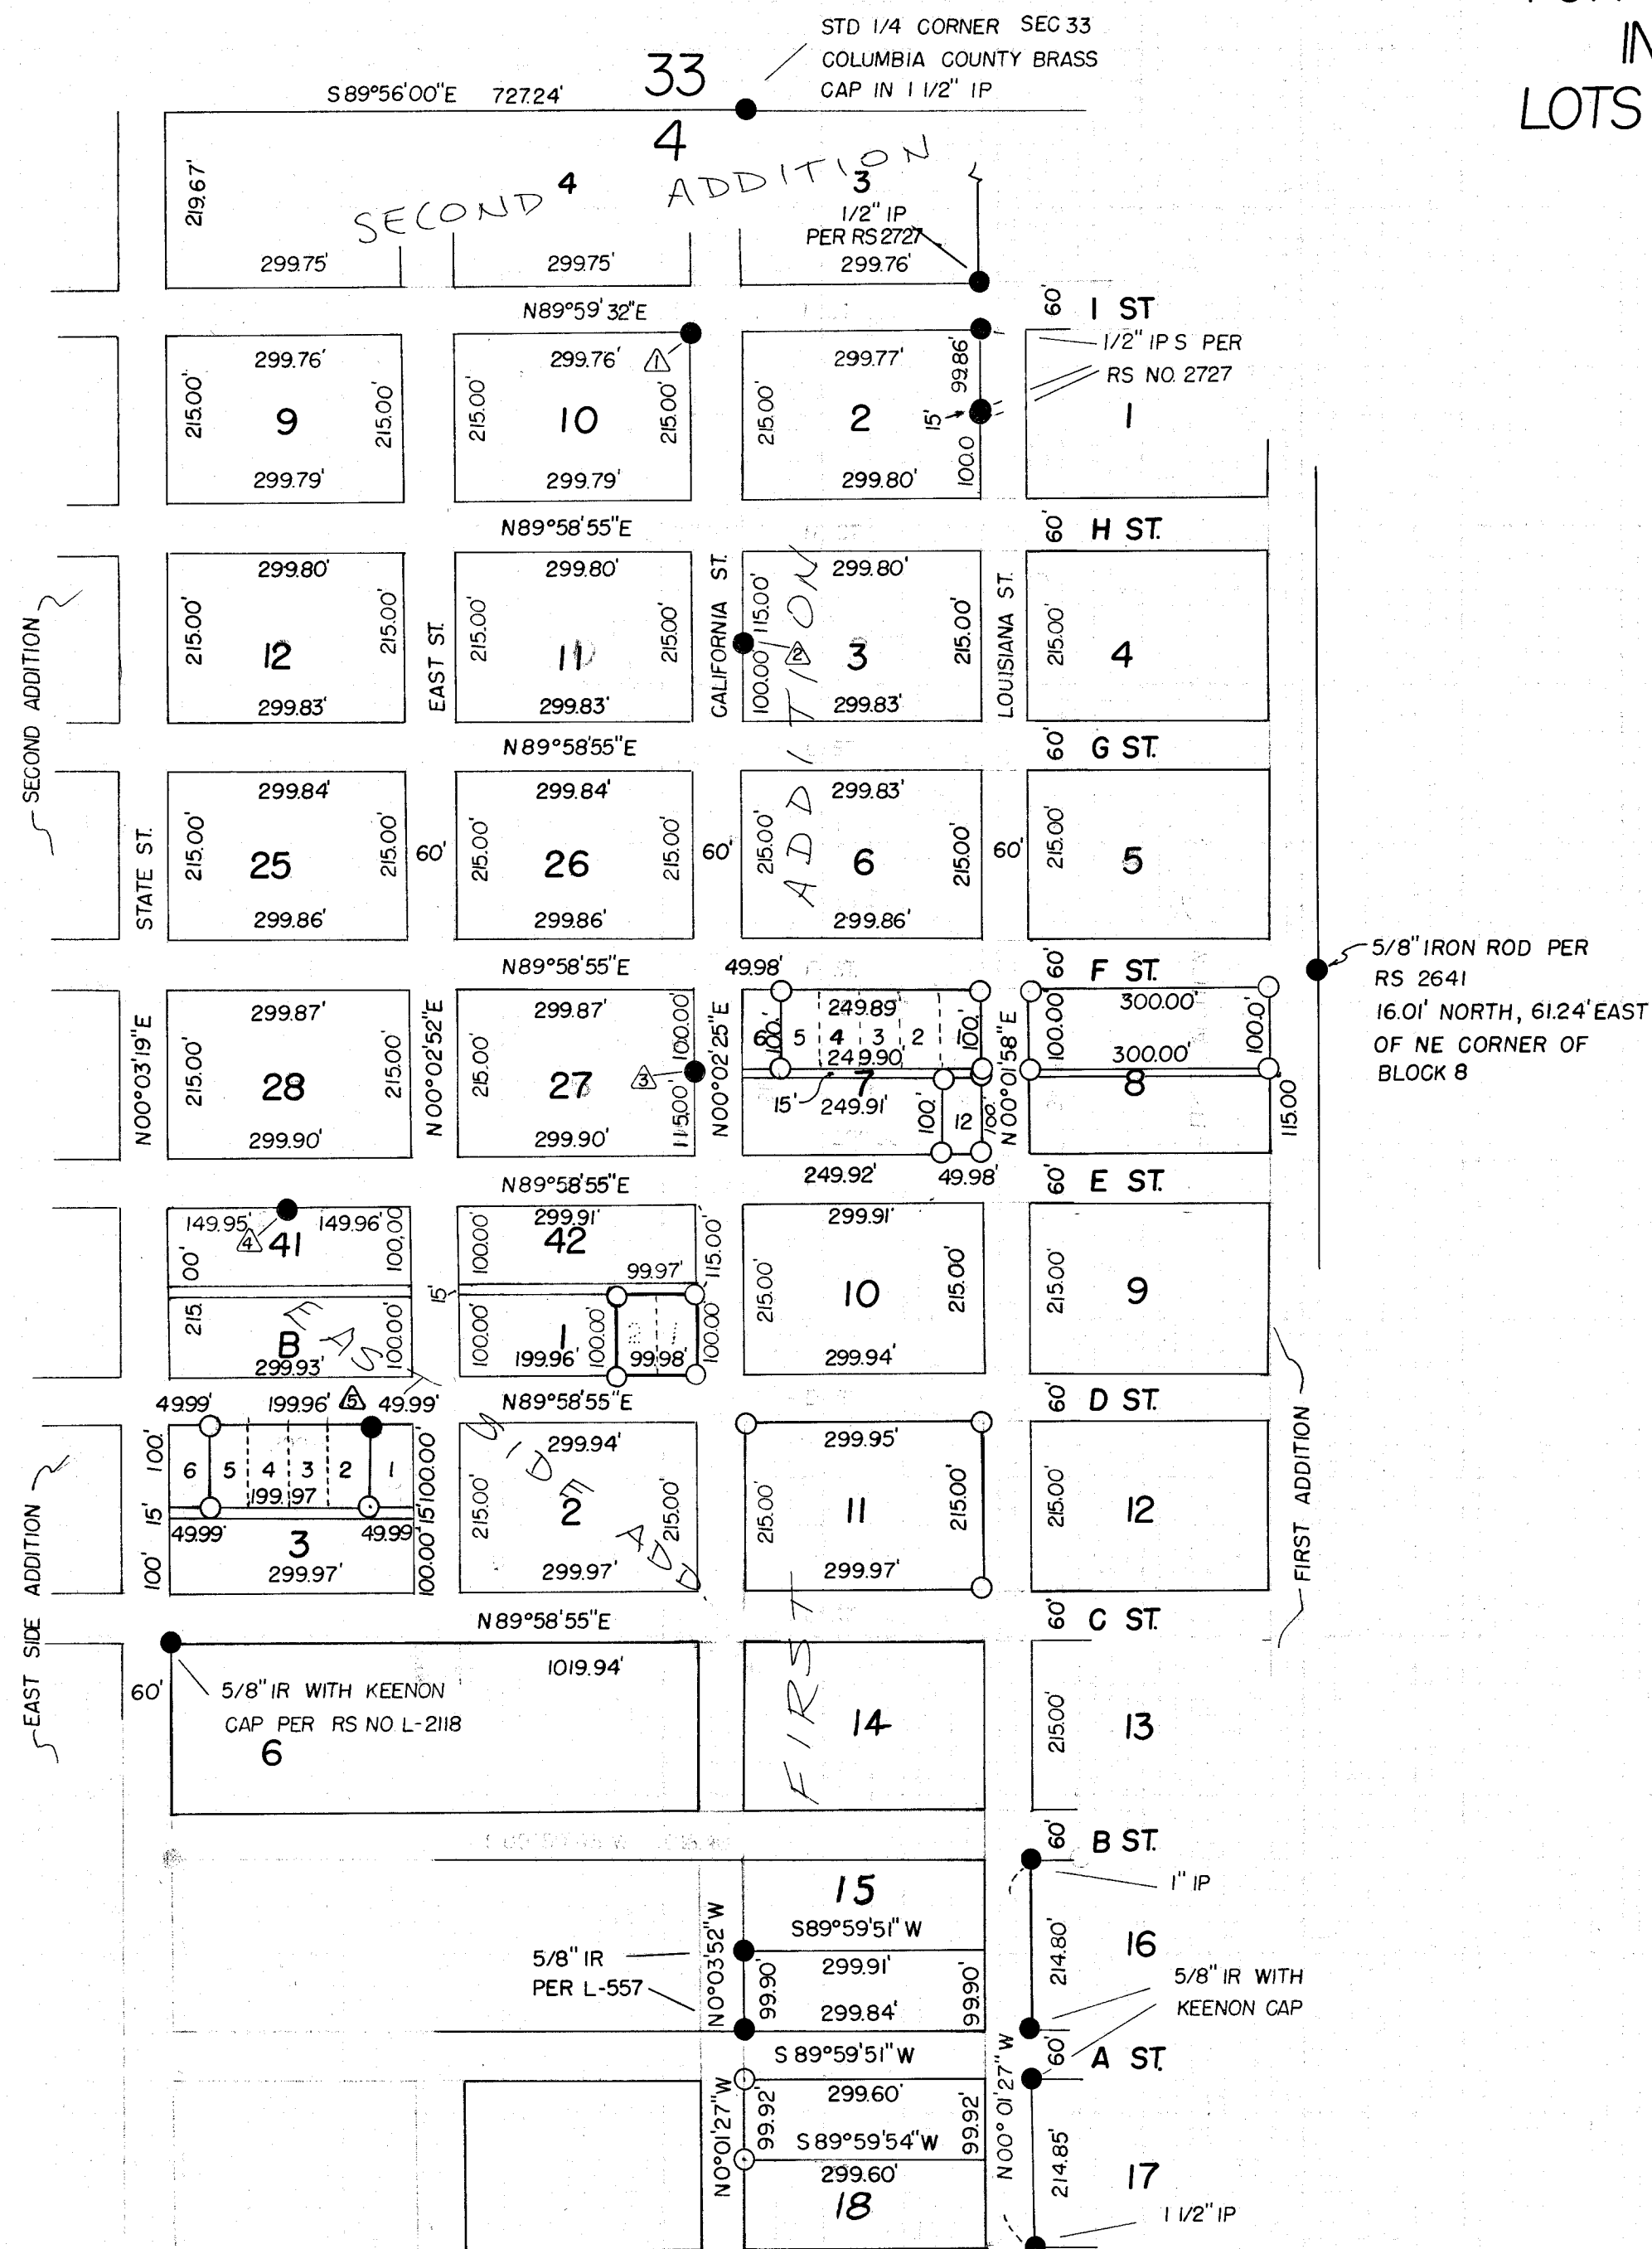

NARRATIVE: THIS SURVEY WAS ACCOMPLISHED AT THE REQUEST OF SAM CEBALLOS TO MONUMENT LOTS 1 AND 2 OF BLOCK 1, EAST SIDE ADDITION TO VERNONIA. THE BASIS OF BEARINGS IS THE EAST LINE OF STATE STREET FROM RECORD SURVEY NO. 3806

PROCEDURE

1. FOR CONTROL I HELD THE 5/8" IR AT THE NW CORNER OF BLOCK 6 EAST SIDE ADDITION TO VERNONIA AS PER RECORD SURVEY NO. L-2118, THE 1/2" IP AT THE NE CORNER OF LOT 12 BLOCK 2 SECOND ADDITION TO VERNONIA AS PER RECORD SURVEY NO. 2727 AND THE 1" IP AT THE NW CORNER OF BLOCK 16 FIRST ADDITION TO VERNONIA.
 2. I HELD THE DISTANCE FROM THE STANDARD 1/4 CORNER OF SECTION 33 TO THE EAST LINE OF STATE STREET AS PER RECORD SURVEY NO. 3806
 3. I HELD THE RECORD DISTANCES FOR NORTHINGS AND PROPORTIONED THE EASTINGS BETWEEN THE EAST LINE OF STATE STREET AND THE WEST LINE OF LOUISIANA STREET.
- NOTE: LOTS 2-5 OF BLOCK 3 WERE SURVEYED AT THE REQUEST OF CHARLES DAVIS. LOTS 1-5 AND 12 BLOCK 7, LOTS 1-6 BLOCK 8, AND BLOCK 11, FIRST ADDITION TO VERNONIA WERE SURVEYED FOR RAY BOURSAW.

LEGEND

- - MONUMENT FOUND AS NOTED
 - - SET A 5/8" X 30" IRON ROD WITH A YELLOW PLASTIC CAP MARKED "KEENON LS 1080"
 - () - RECORD DATA
 - IP - IRON PIPE
 - IR - IRON ROD
 - △ - MONUMENT INFORMATION
- | | |
|------------|-----------------------------|
| 1. 5/8" IR | S 0.19° W 1.57' |
| 2. 1/2" IP | RS NO. 2727 S 0.34° W 0.74' |
| 3. 1" IP | W 3.38' |
| 4. 5/8" IR | S 0.36° E 0.69' |
| 5. 5/8" IR | S 0.09° W 0.03' |

L JERRY KEENON
1311 ALDER ST.
VERNONIA, OREGON 97064
PH # 429-6115

REGISTERED
PROFESSIONAL
LAND SURVEYOR

OREGON
JULY 30, 1976
LESLIE G. KEENON
1080

COUNTY SURVEYOR
RECEIVED 9-16-93
FILED 4-28-94