


RECORD OF SURVEY
FOR THE CITY OF VERNONIA
IN THE NE 1/4 OF SEC 5, T4N, R4W, W.M.
COLUMBIA COUNTY, OREGON
SCALE 1" = 200' DEC 28, 1994

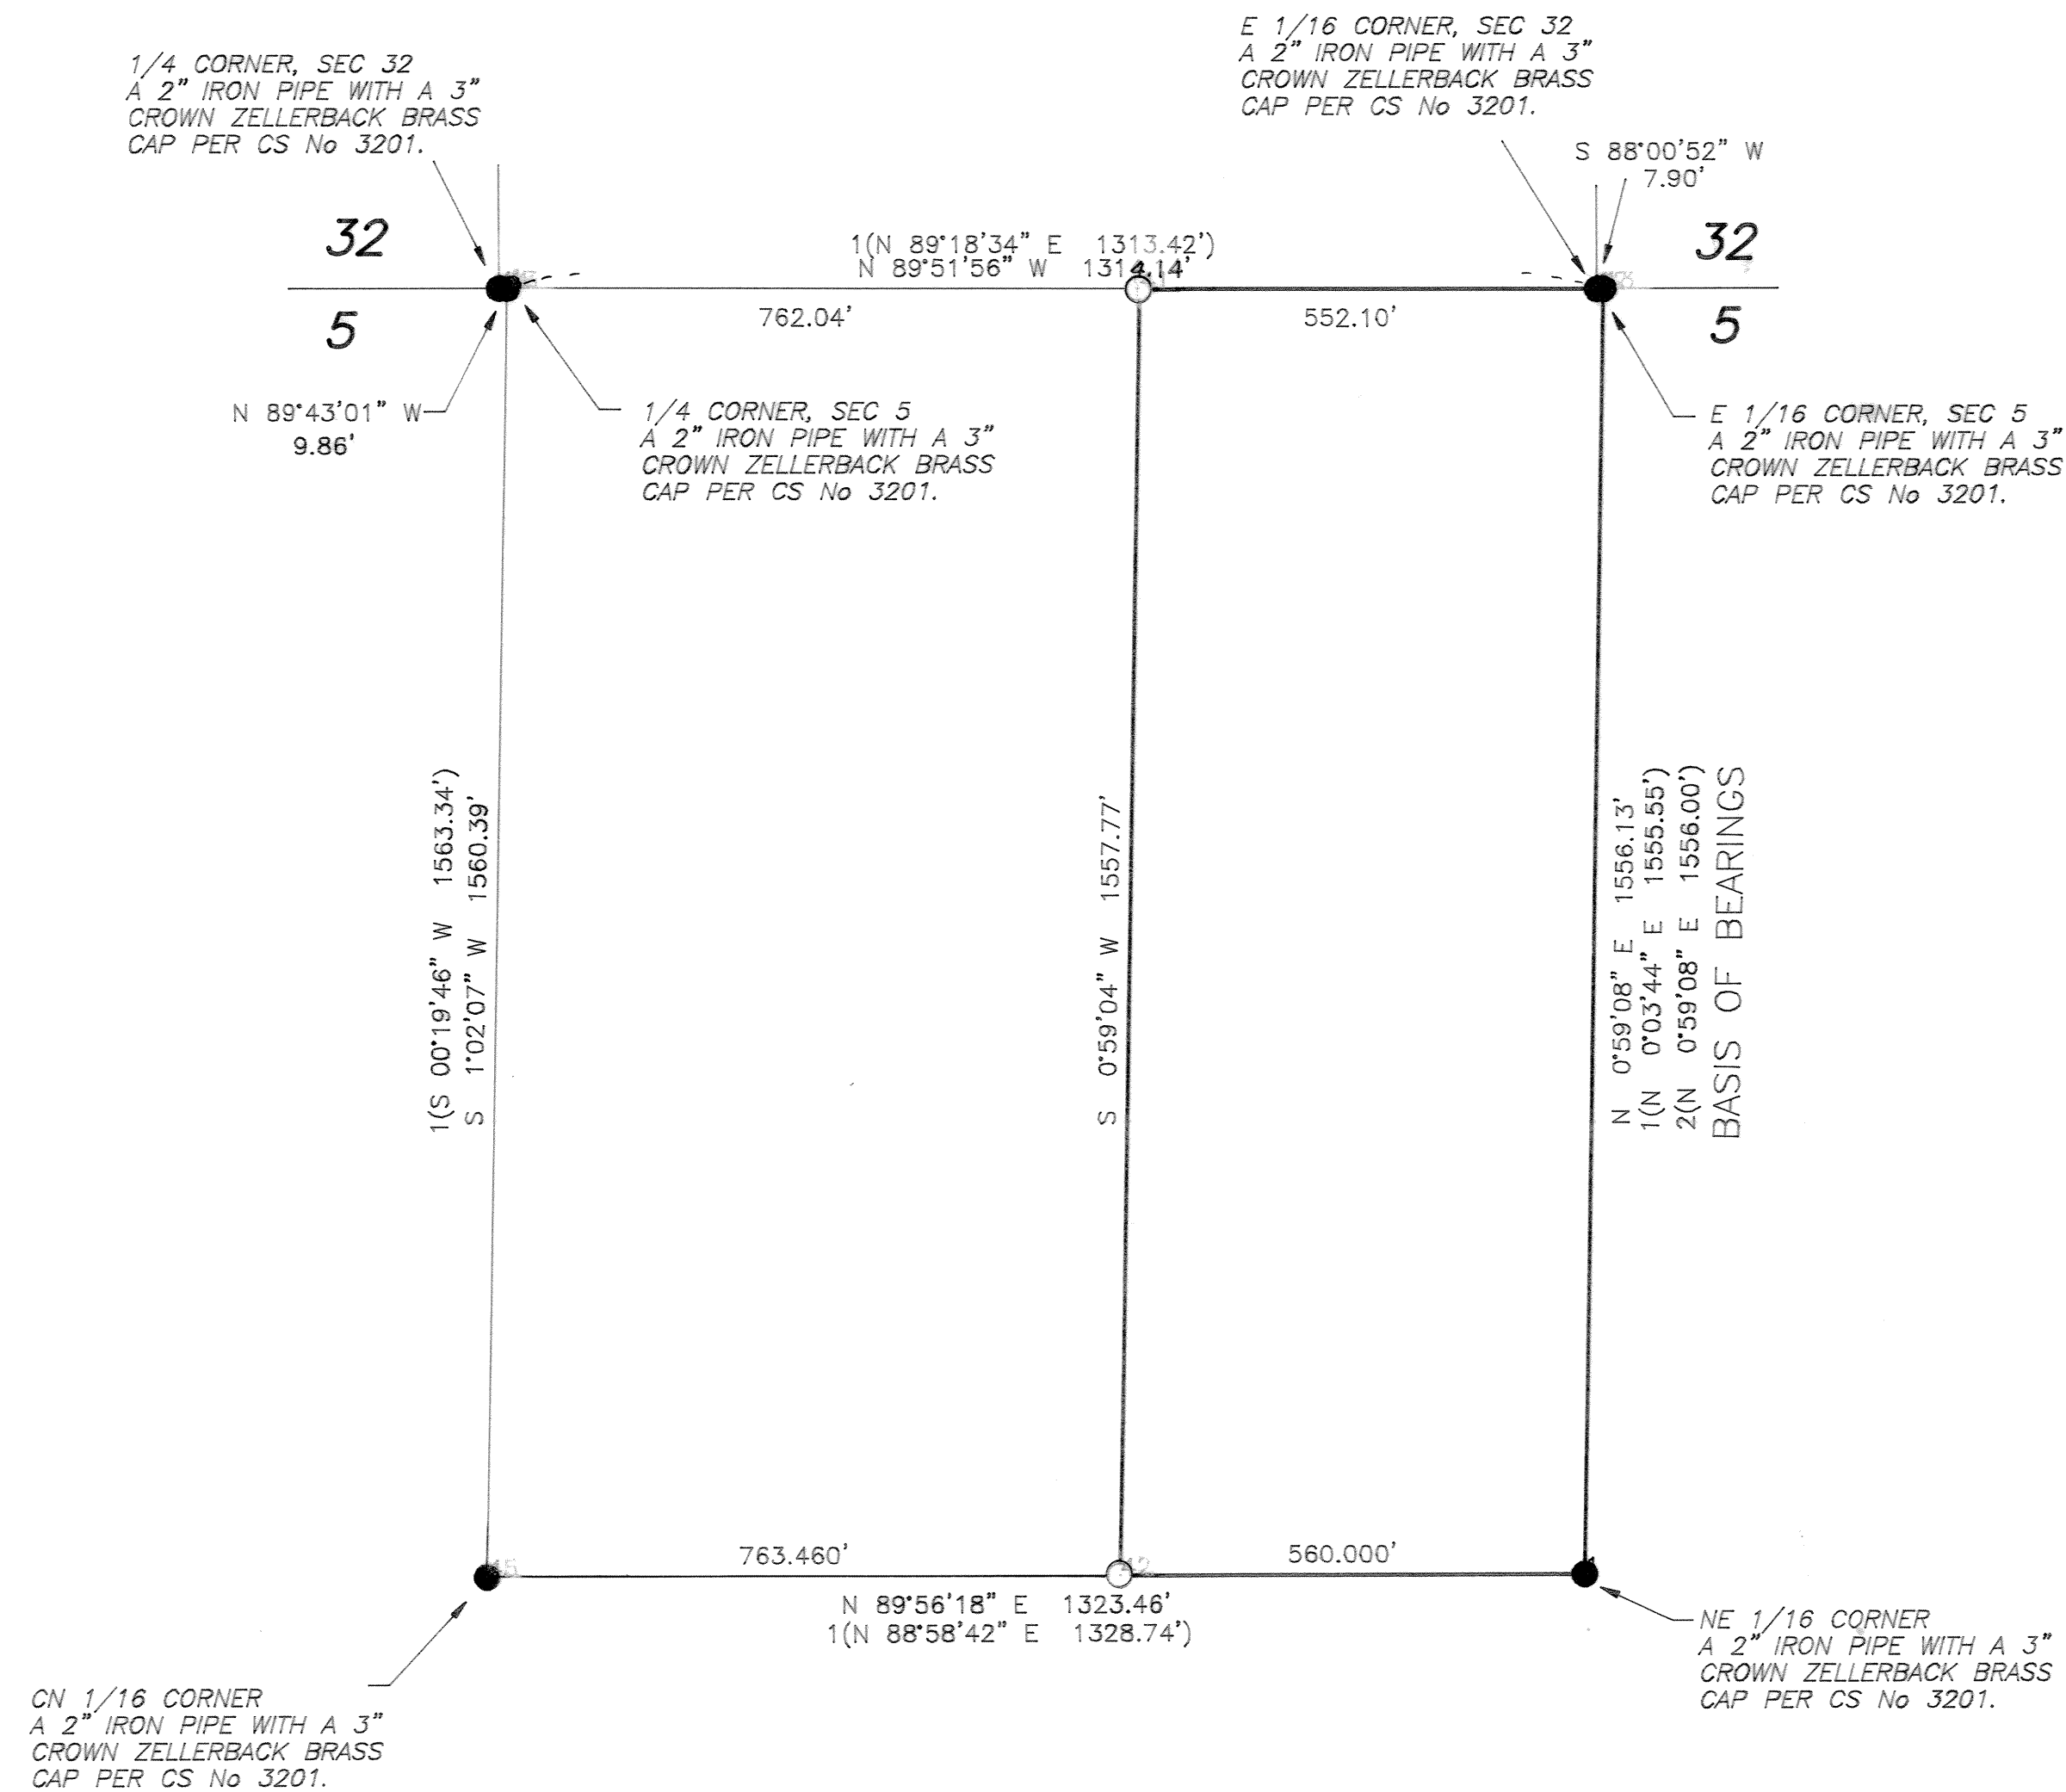

NARRATIVE:



THIS SURVEY WAS ACCOMPLISHED AT THE REQUEST OF THE CITY OF VERNONIA TO MARK AND MONUMENT THE TRACT AS SHOWN. THE BASIS OF BEARINGS IS FROM CS No. 3960. I HELD THE MONUMENTS AS SET IN CS No. 3201 TO CONTROL THE NE 1/4 OF SECTION 5.

PROCEDURE:

1. FOR THE NORTHEAST CORNER I HELD THE 2" IRON PIPE WITH 3" CROWN ZELLERBACH BRASS CAP AS SET IN CS No. 3201.
2. FOR THE SOUTHEAST CORNER I HELD THE 2" IRON PIPE WITH 3" CROWN ZELLERBACH BRASS CAP AS SET IN CS No. 3201.
3. I ESTABLISHED THE NORTHWEST CORNER AT THE DEEDED DISTANCE ALONG THE NORTH LINE OF THE NW 1/4 OF THE NE 1/4 FROM THE E 1/16 CORNER, SECTION 5 AS ESTABLISHED IN CS No. 3201.
4. I ESTABLISHED THE SOUTHWEST CORNER AT THE DEEDED DISTANCE ALONG THE SOUTH LINE OF THE NW 1/4 OF THE NE 1/4 FROM THE NE 1/16 CORNER AS ESTABLISHED IN CS No. 3201.

LEGEND

- = MONUMENT FOUND AS NOTED
- = SET A 5/8" X 30" IRON ROD WITH A YELLOW PLASTIC CAP MARKED "KEENON LAND SERVICES INC."
- () = RECORD DATA 1 = CS No. 3201
2 = CS No. 3960
- CS = RECORD SURVEY NO.

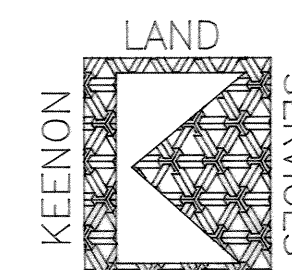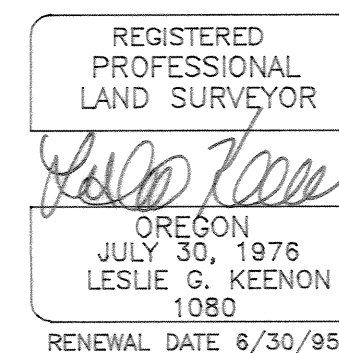

1224 ALDER ST.
VERNONIA, OR
97064
(503) 429-6115

COLUMBIA COUNTY SURVEYORS OFFICE
RECIEVED 1-16-95
ACCEPTED FOR FILING 4-11-95