

**RECORD OF SURVEY
FOR LONGVIEW FIBRE COMPANY
IN THE NE1/4 OF SEC 7 T4N, R4W, W.M.
COLUMBIA COUNTY, OREGON
SCALE 1" = 200' SEPT 6, 1994**

NARRATIVE
THE PURPOSE OF THIS SURVEY WAS TO MARK AND MONUMENT THE BOUNDARIES OF THE TRACTS AS SHOWN.
BEARINGS ARE BASED ON THE E-W CENTERLINE OF THE SECTION FROM RS 3891.

BEARINGS TO REFERENCES WERE TAKEN WITH A HAND COMPASS DECLINATION 21° E, AND DISTANCES WERE MEASURED TO THE HEAD OF A SPIKE. ALL NEW TREES WERE MARKED WITH 4 BLAZES UP THE FACE, A 3" TRACK SPIKE IN THE BASE OF THE BOTTOM BLAZE, AND LOCATION TAGS ABOVE THE BLAZES.

PROCEDURE


1. HELD THE MONUMENTS AS NOTED AT THE W 1/4, E 1/4, N 1/4, S 1/4, AND THE NE SECTION CORNER.
2. THE SECTION WAS SUBDIVIDED ACCORDING TO CHAPTER 3-89 OF THE MANUAL OF SURVEYING INSTRUCTIONS, 1973.
3. FOR THE NE CORNER OF THE TRACT AS DESCRIBED IN DEED DOCUMENT 88-4037 I HELD THE MIDPOINT BETWEEN THE N 1/16 CORNER AND THE W NE 1/64 CORNER PER DEED.
4. FROM THE NE CORNER I HELD THE DEEDED DISTANCE SOUTH PARALLEL WITH THE WEST LINE OF THE SE 1/4 OF THE NE 1/4 PER DEED.
5. FROM THE CORNER ESTABLISHED IN PROCEDURE 4 I HELD THE BEARING PARALLEL TO THE NORTH LINE OF THE SE 1/4 OF THE NE 1/4 AND EXTENDED IT TO A POINT 60' WEST OF THE WEST LINE OF THE SE 1/4 OF THE NE 1/4 AS PER DEED.
6. FROM THE CORNER ESTABLISHED IN PROCEDURE 5 I HELD THE BEARING PARALLEL TO THE WEST LINE OF THE SE 1/4 OF THE NE 1/4 AND SET A MONUMENT ON THE NORTH BANK OF THE NEHALEM RIVER.
7. THE NW CORNER IS THE W-NE 1/64 CORNER.
8. FOR THE SW CORNER I SET A POINT ON THE WEST LINE OF THE EAST 1/2 OF THE SW 1/4 OF THE NE 1/4 ON THE NORTH BANK OF THE NEHALEM RIVER.

LEGEND

- = MONUMENT FOUND AS NOTED
- = SET A 5/8" X 30" IRON ROD WITH A YELLOW PLASTIC CAP MARKED "KEENON LAND SERVICES INC."
- () = RECORD DATA 1 = RS = B-75 2 = RS 3099
3 = RS 3891 4 = RS 3805
- RS = RECORD SURVEY NO.

REGISTERED
PROFESSIONAL
LAND SURVEYOR


Leslie G. Keenon
OREGON
JULY 30, 1976
LESLIE G. KEENON
1080
RENEWAL DATE 6/30/95

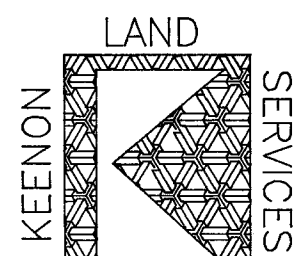

1224 ALDER ST.
VERNONIA, OR
97064
(503) 429-6115

12 7

- 1/4 CORNER
A 1 1/2" IRON PIPE WITH A 2 1/2" COLUMBIA COUNTY BRASS CAP ON TOP
REFERENCES
1895
BROKEN FRUIT JAR AT CORNER 20" DOWN
S 60 E 5.0' BROKEN CROCKERY 6"-10" DOWN
1948
1 1/2" IRON PIPE N 60 W 5.0'
1968
1 1/4" IRON PIPE N 20 W 7.17'
A 26" FIR STUMP S 50 W 24'
1993
A 13" FIR N 60 E 56.52' TO SPIKE
A 7" GRAND FIR S 79 W 34.25' TO SPIKE
A 10" CEDAR S 28 E 50.69' TO SPIKE
A 6" BOAT SPIKE IN CL OF CO. RD N 32 W 46.16'

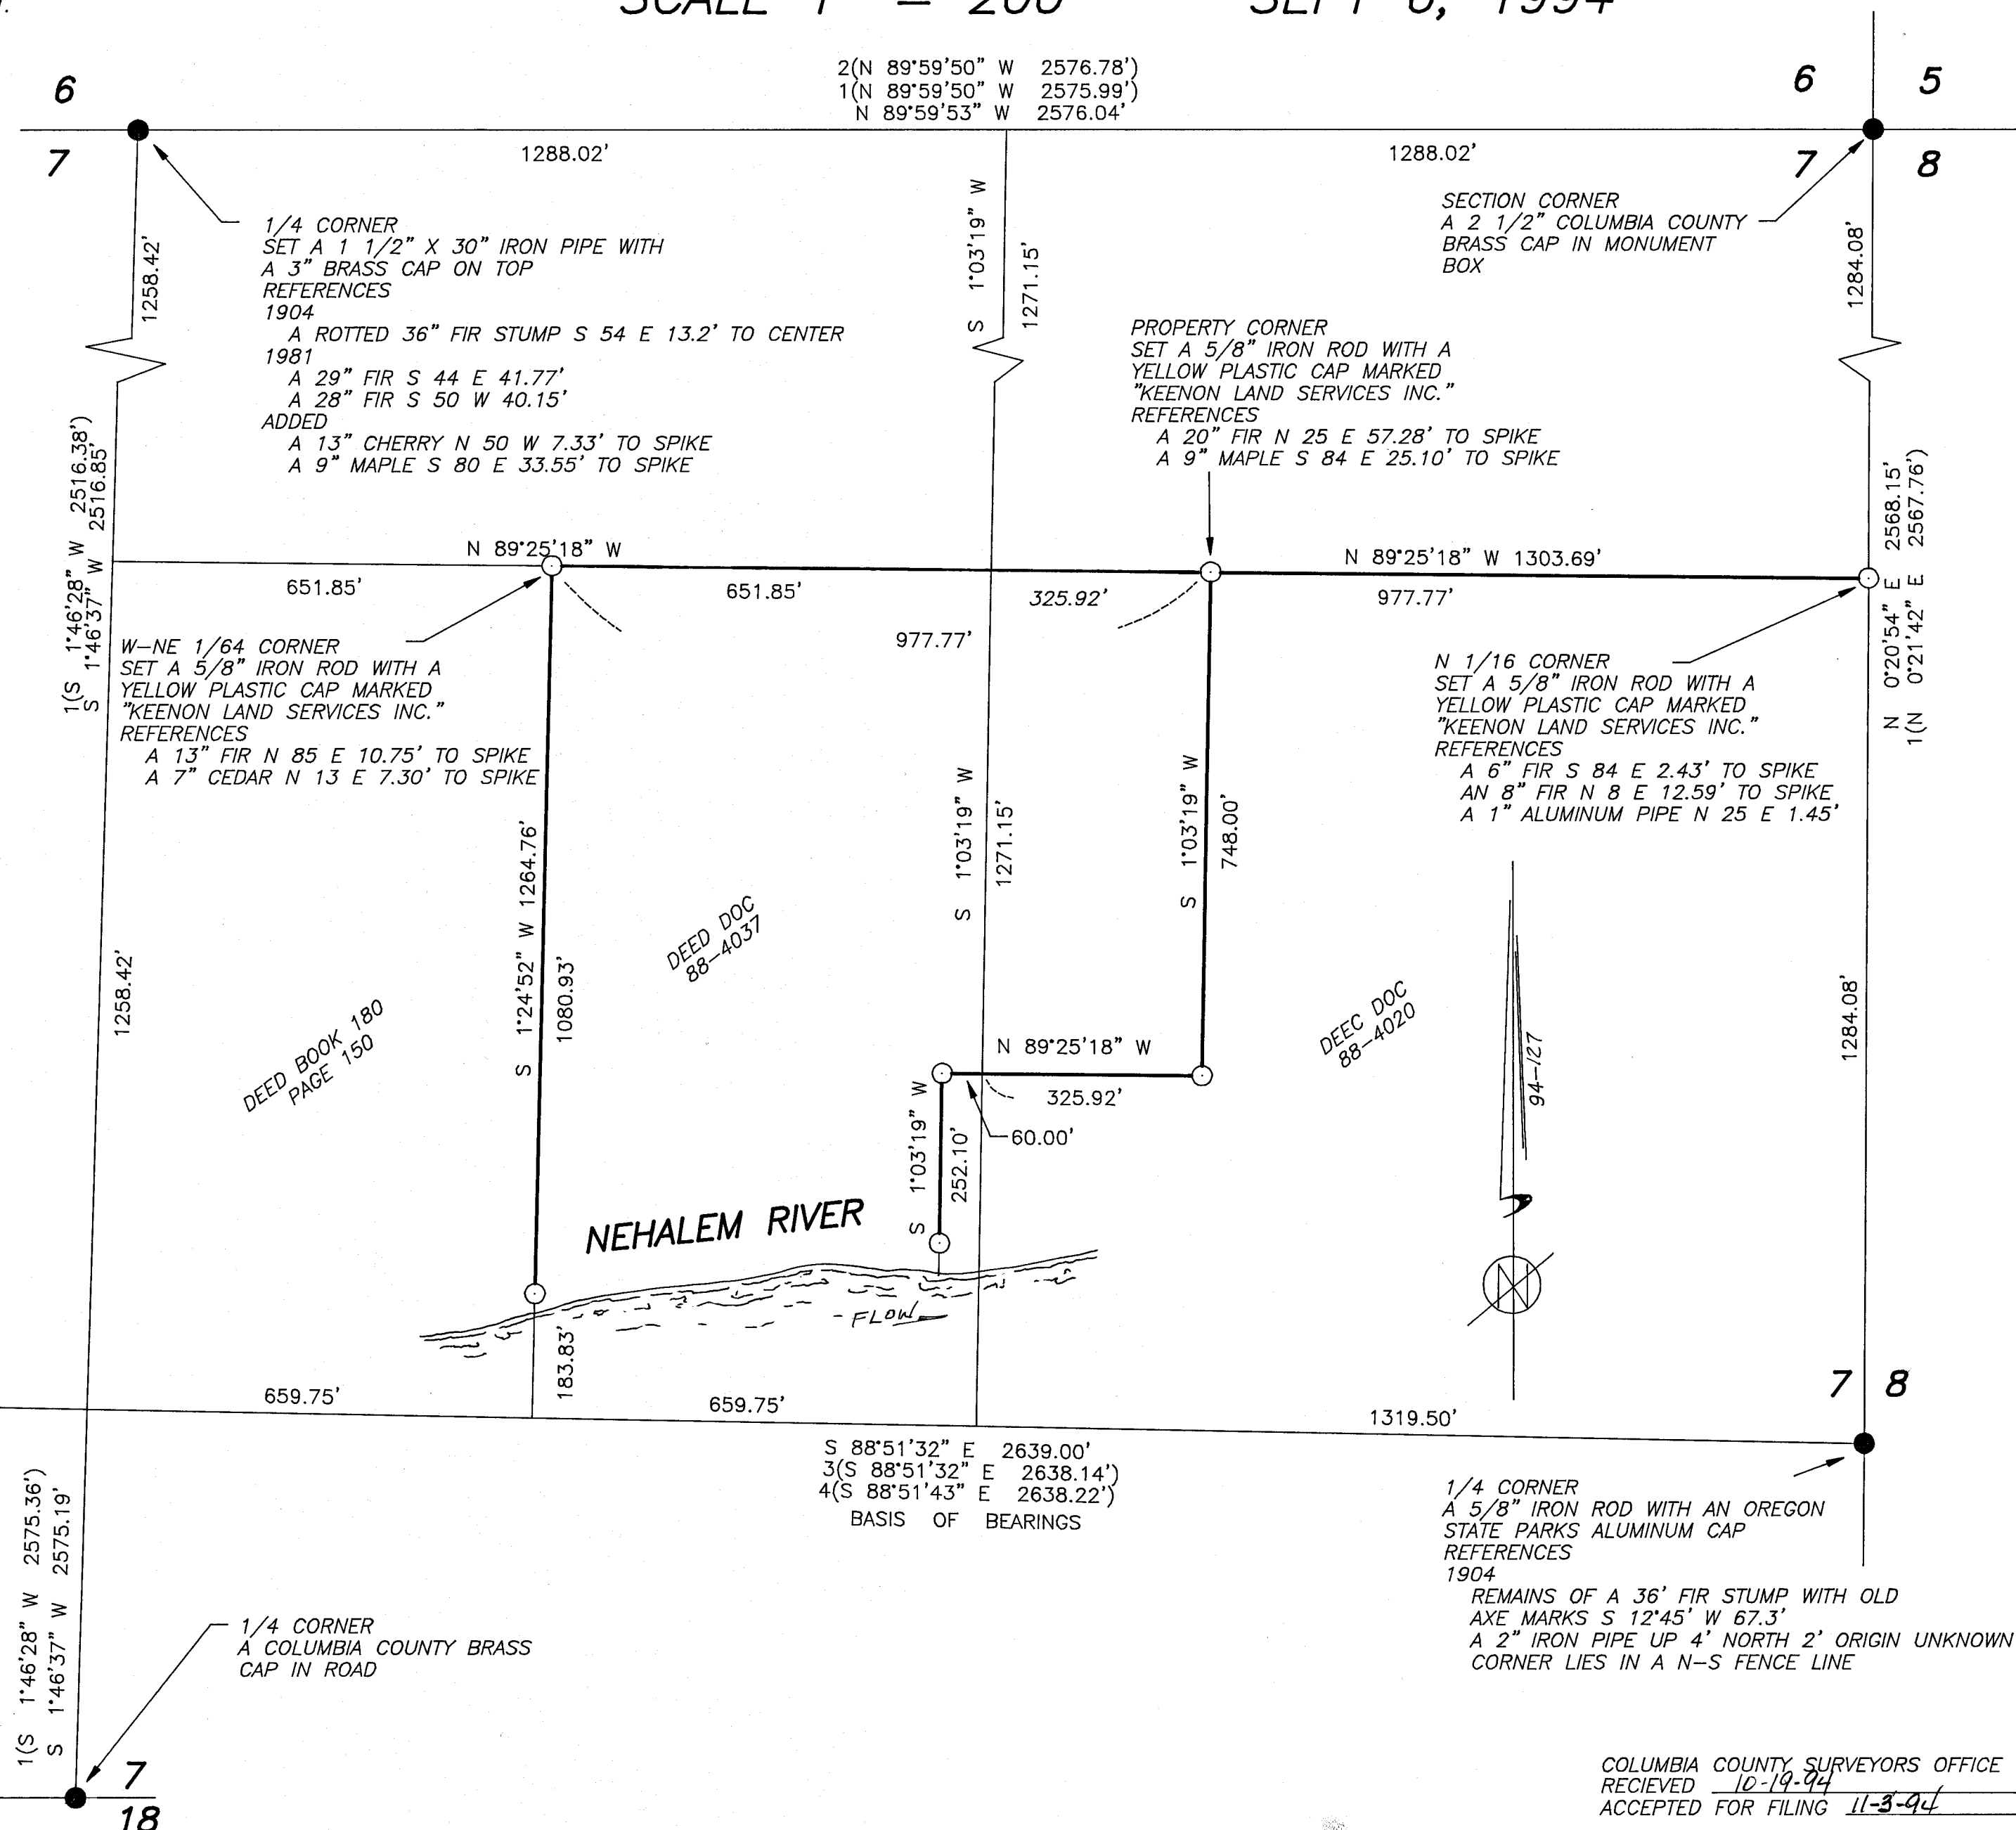

COLUMBIA COUNTY SURVEYORS OFFICE
RECIEVED 10-19-94
ACCEPTED FOR FILING 11-3-94