


B-145

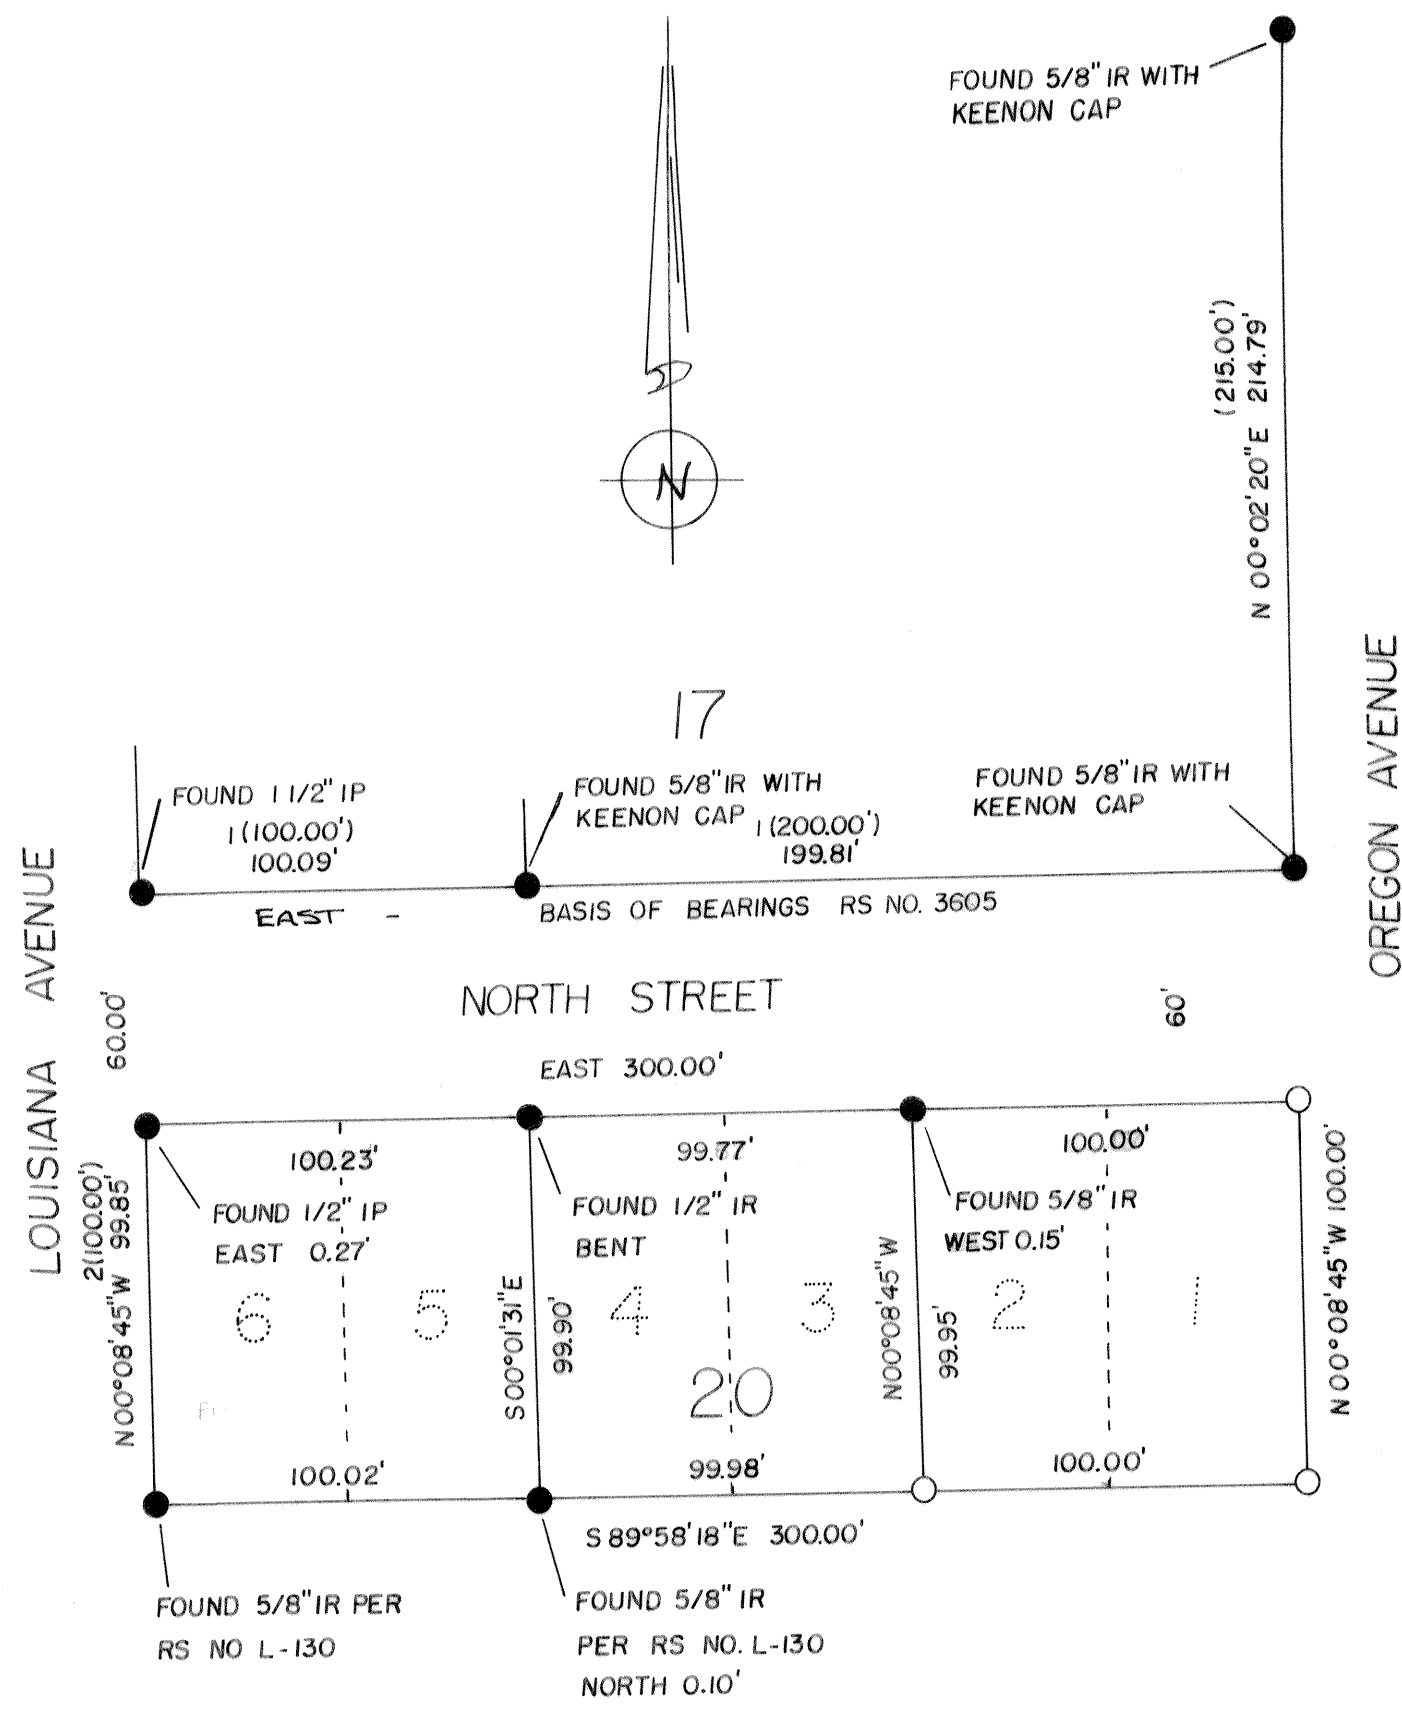

RECORD OF SURVEY  
for RON GREEN

LOTS 1 AND 2, BLOCK 20  
FIRST ADDITION TO VERNONIA  
IN THE NE 1/4, SEC 4, T4N, R4W, WM.  
COLUMBIA COUNTY, OREGON  
SCALE 1"=50' APRIL 2, 1992

NARRATIVE: THIS SURVEY WAS ACCOMPLISHED AT THE REQUEST  
RON GREEN TO MONUMENT LOTS 1 AND 2, BLOCK 20, FIRST  
ADDITION TO VERNONIA. THE BASIS OF BEARINGS IS THE NORTH  
LINE OF NORTH STREET, FIRST ADDITION TO VERNONIA. FOR  
CONTROL I HELD THE MONUMENTS ON THE SOUTH LINE OF  
BLOCK 17 AND THE SW CORNER OF BLOCK 20.

LEGEND

- - MONUMENT FOUND AS NOTED
- - SET A 5/8" X 30" IR WITH PLASTIC CAP  
MARKED "KEENON LS 1080"
- ( ) - RECORD DATA  
1 = RS NO. 3605  
2 = RS NO. L-130
- RS - RECORD SURVEY

L. JERRY KEENON  
1311 ALDER ST.  
VERNONIA, OREGON 97064

REGISTERED  
PROFESSIONAL  
LAND SURVEYOR

LAND SURVEY

*Leslie G. Keenon*

OREGON  
JULY 30, 1978  
LESLIE G. KEENON  
1080

COUNTY SURVEYOR  
RECEIVED 6-4-92  
FILED 7-6-92

DRAWN BY: DON WALLACE

B-145

9-15