


96LS

5796

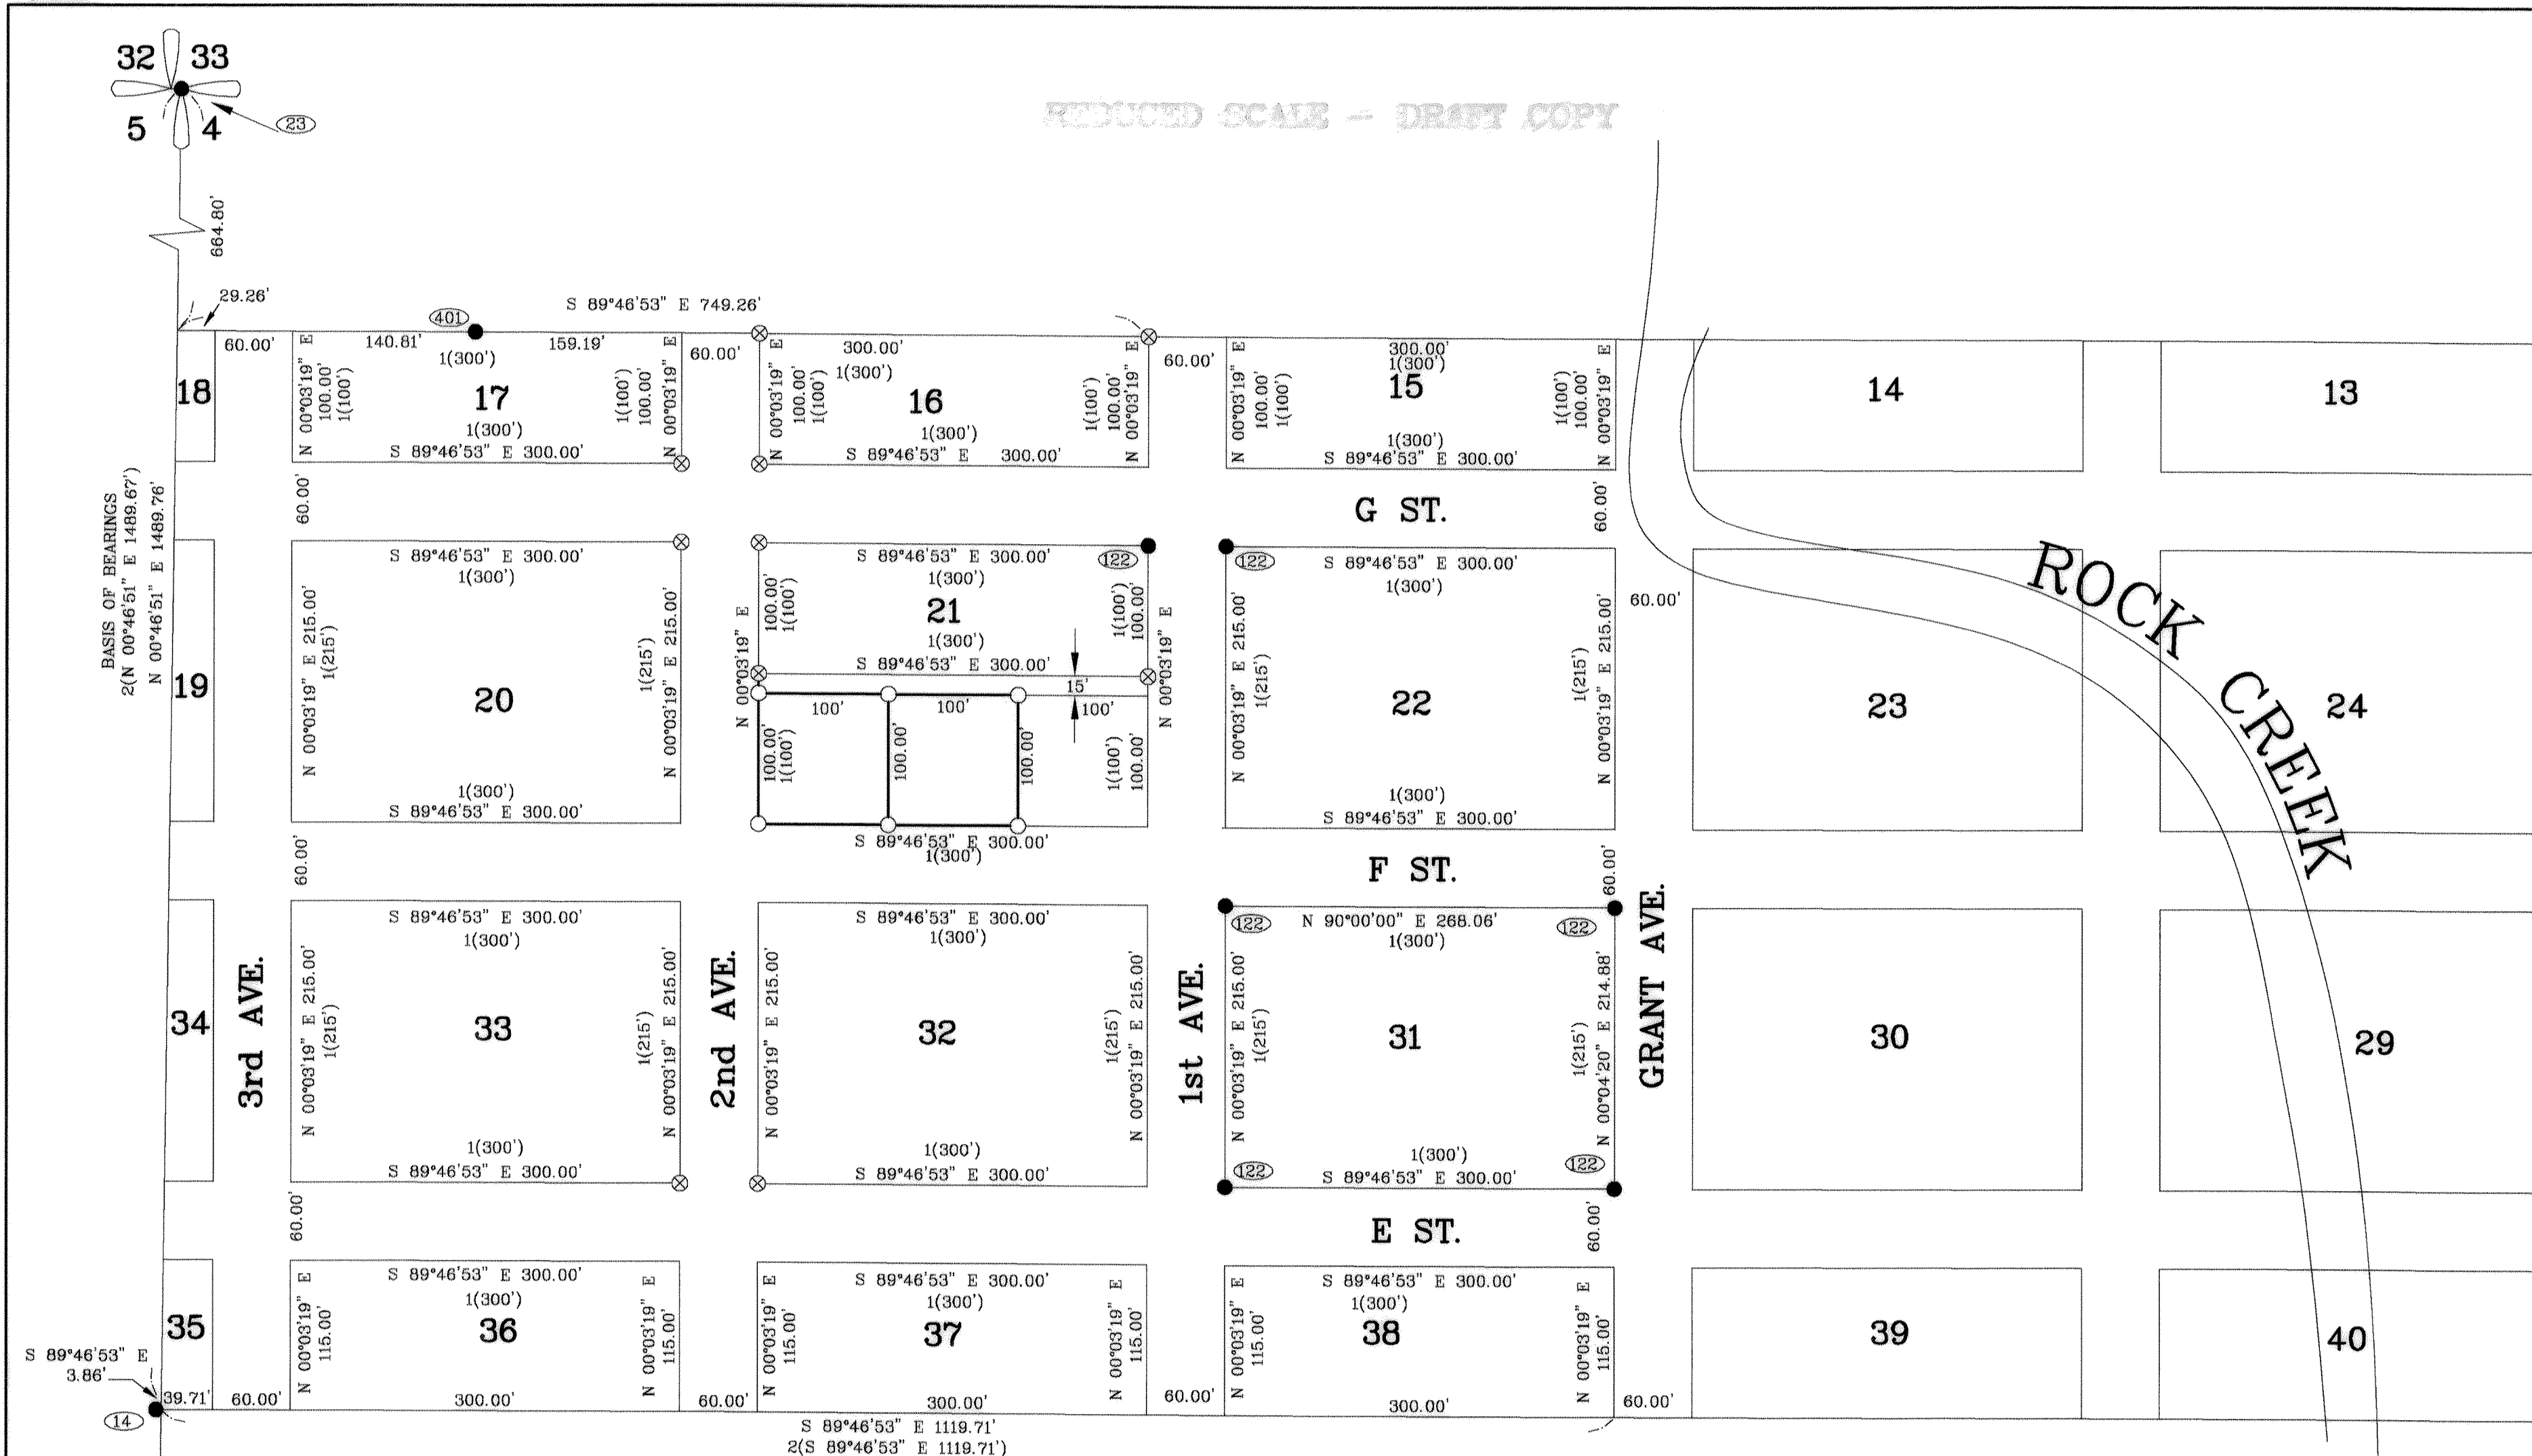

### NARRATIVE:

--THIS SURVEY WAS MADE AT THE REQUEST OF FRANK SCHRIER TO MONUMENT THE LOT CORNERS IN BLOCK 21 AS SHOWN IN SECOND ADDITION TO VERNONIA.

--BASIS OF BEARINGS IS THE WEST LINE OF SECTION 4 AS SHOWN IN CS 3806.

--FOR CONTROL I HELD THE RESOLUTION OF BLOCKS 13-40 PER CS 3806 AND THE MONUMENTATION PER CS NO. 5078.

### REFERENCE SURVEYS

- 1 = CS NO. 129
- 2 = CS NO. 3806
- 3 = CS NO. L-2155
- 4 = CS NO. L-1504
- 5 = CS NO. 3201
- 6 = CS NO. 5078

### MONUMENT NOTES:

- (14) FOUND A 1" IRON PIPE N 89°46'53" W 3.86' PER CS NO. L-1504
- (23) FOUND SECTION CORNER, A 2" IRON PIPE AS NOTED IN CS 3806
- (122) FOUND A 5/8" IRON ROD WITH YELLOW PLASTIC "KEENON LS 1080" CAP PER CS 3806
- (401) FOUND A 5/8" IRON ROD WITH YELLOW PLASTIC CAP "KEENON LS 1080" PER CS L-2155

### LEGEND

- ⊗ = FOUND A 5/8" x 30" IRON ROD WITH A Y.P.C. MARKED "KEENON LAND SERVICES INC." PER CS NO. 5078.
- = MONUMENT FOUND AS NOTED
- = SET A 5/8" x 30" IRON ROD WITH A Y.P.C. MARKED "KEENON LAND SERVICES INC."
- ( ) = RECORD SURVEY DATA
- CS = RECORD SURVEY No.
- Y.P.C. = YELLOW PLASTIC CAP
- = MONUMENT POINT No.

REGISTERED PROFESSIONAL LAND SURVEYOR  <i>Donald D. Wallace Jr.</i> OREGON JANUARY 19, 1993 DONALD D. WALLACE JR. 2601 RENEWAL DATE 6/30/06	<b>KEENON LAND SERVICES</b>  1224 ALDER ST. VERNONIA, OR 97064 (503) 429-6115
--	---

SURVEY FOR  
**FRANK SCHRIER**  
 IN SECOND ADDITION TO VERNONIA  
 IN THE NW 1/4 OF SECTION 4,  
 T4N, R4W, W.M.  
 COLUMBIA COUNTY, OREGON  
 SCALE 1" = 100' SEPT. 15, 2004

THIS SURVEY WAS PREPARED  
USING HEWLETT-PACKARD  
PRODUCT # 4844A ON  
CONTINENTAL IMAGING #  
JPC-4M2 POLYESTER FILM.

COLUMBIA COUNTY  
 SURVEYORS OFFICE  
 RECEIVED 10-22-04  
 ACCEPTED 11-19-04

DRAWN BY: DDW    FIELD: TBM/TC    EQUIPMENT: GTS300/TDS48    JOB No. 04-131    PROJECT No. 03-084    REVISED: 9/14/04

5796