


4774

4774

EVERGREEN PARK

NEHALEM ST.

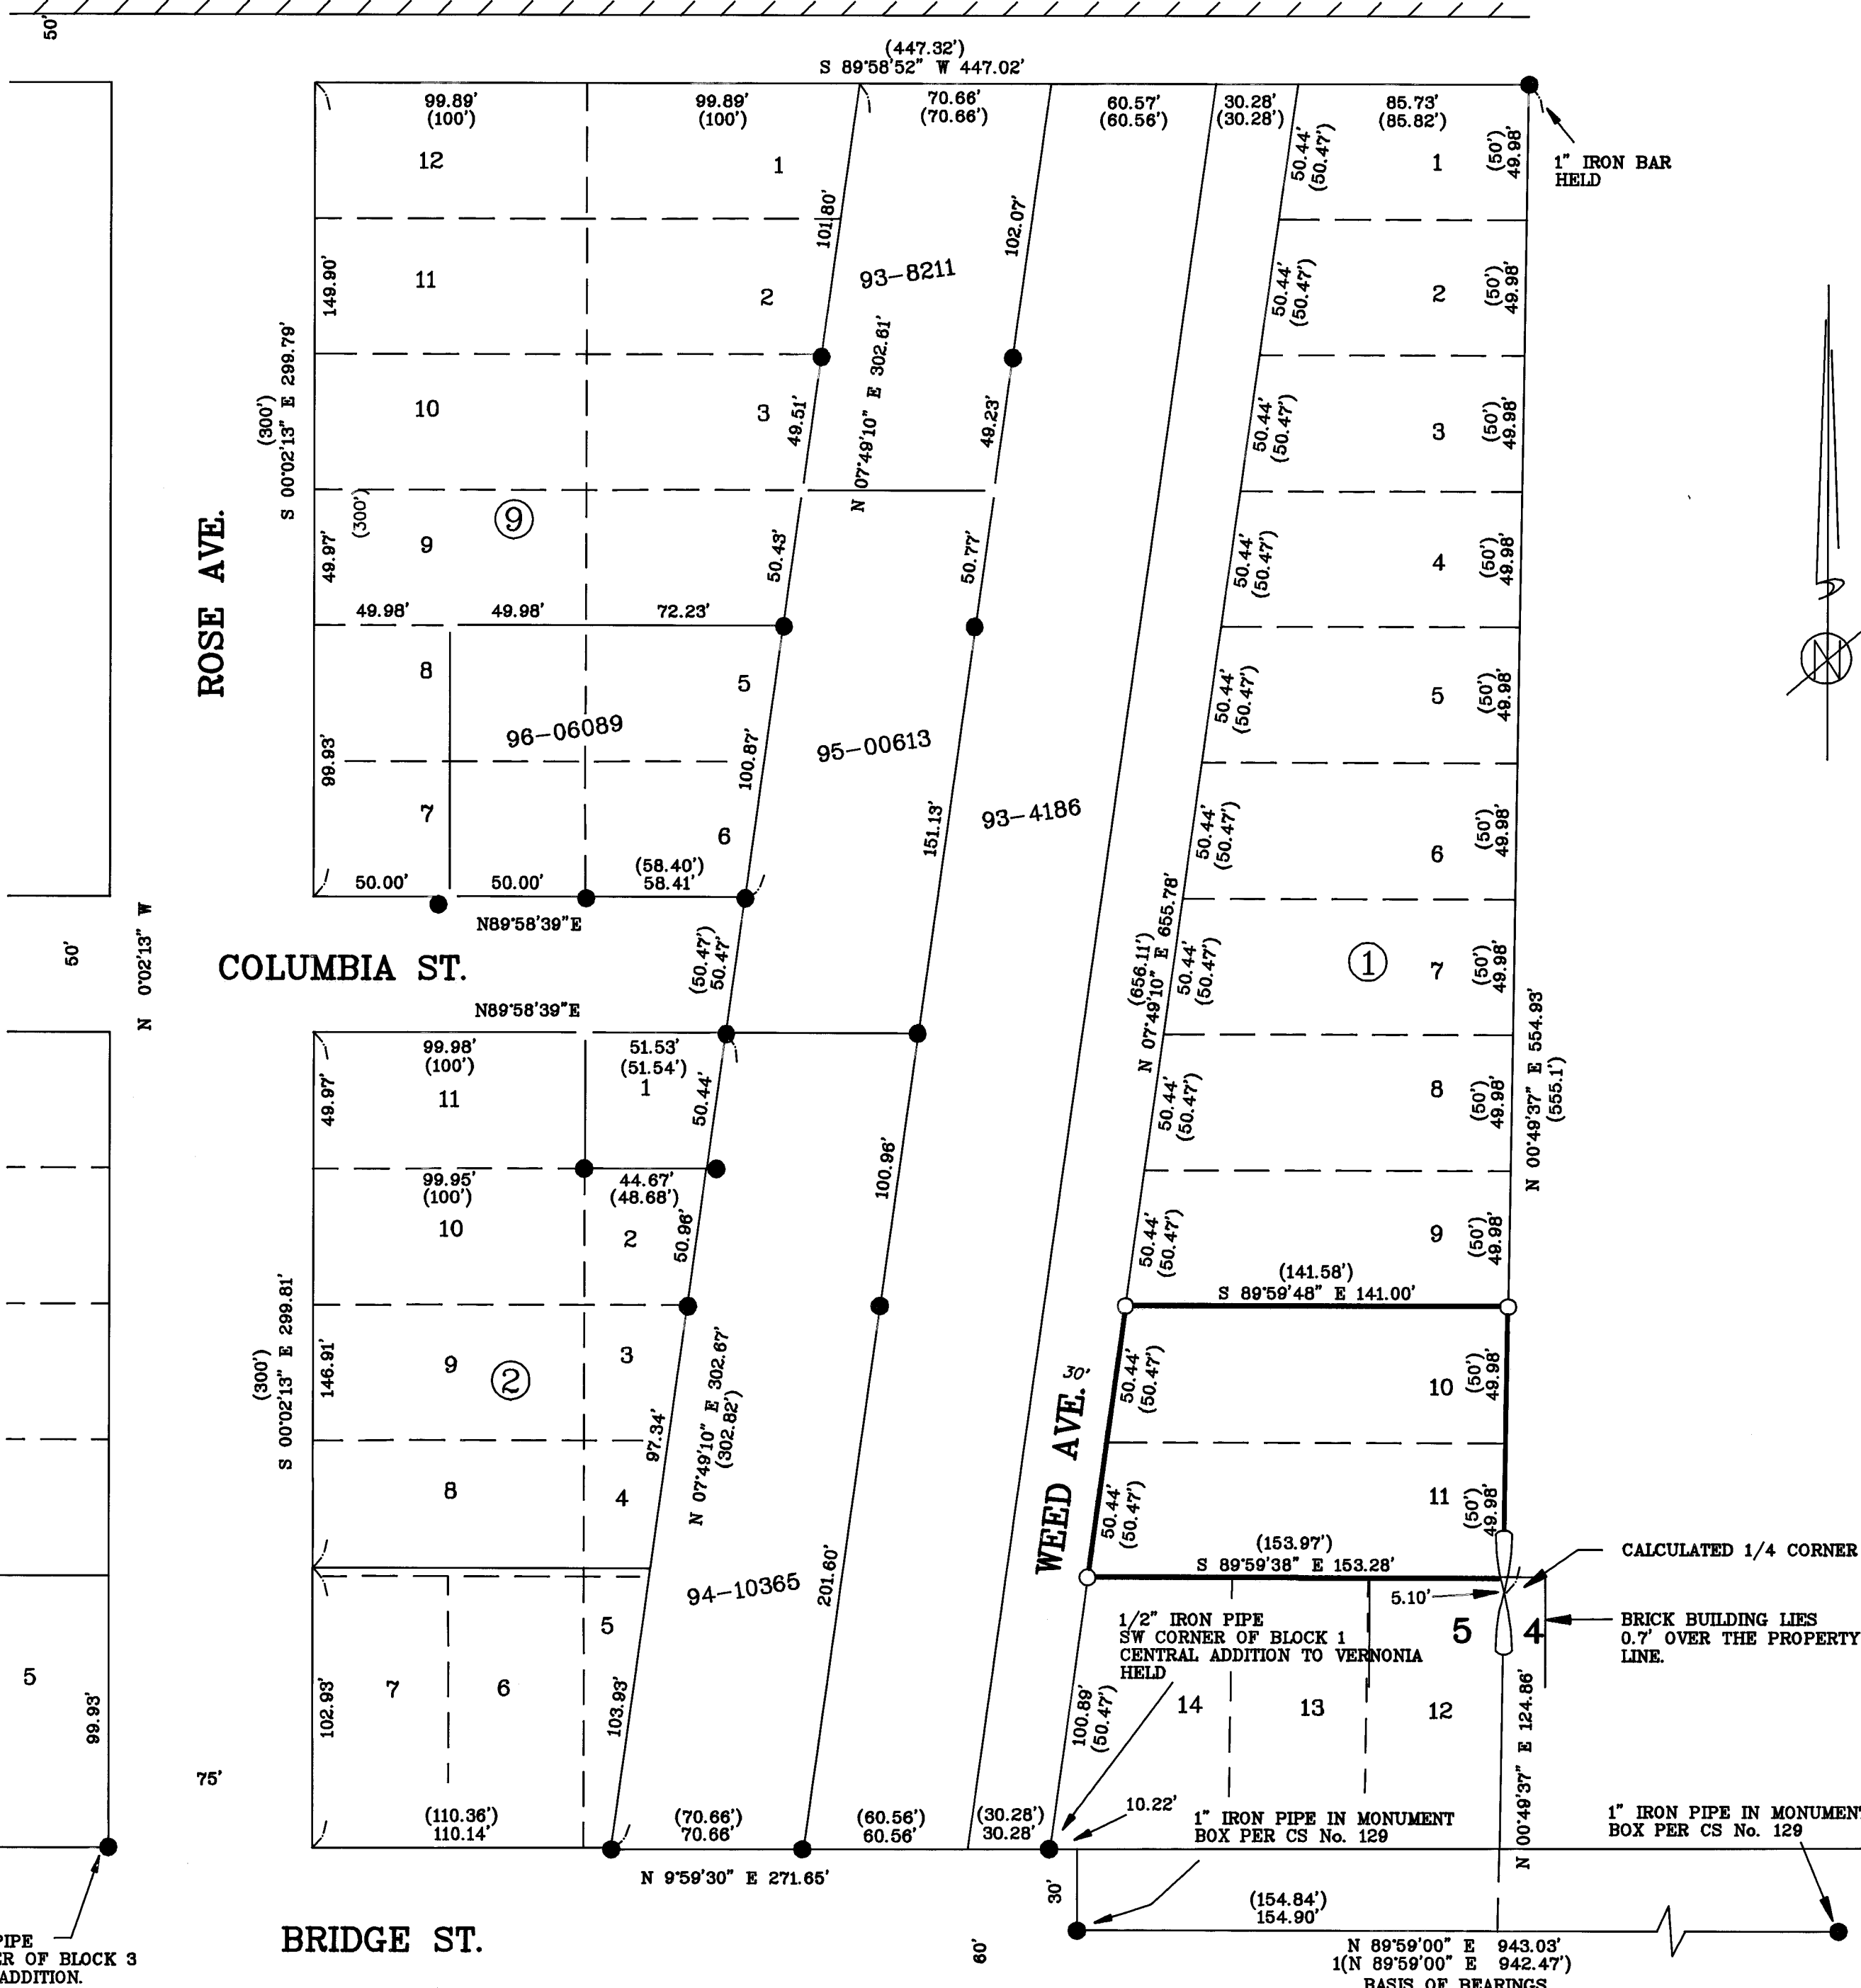

2" IRON PIPE
SW CORNER OF BLOCK 3
CENTRAL ADDITION.

MONUMENT NOTES:

- (2) A 5/8" IRON ROD PER CS No. 3307 S 5°21'08" E 0.45'
- (54) A 5/8" IRON ROD WITH A Y.P.C. MARKED "KEENON LAND SERVICES INC." PER CS No. 4109.
- (55) A 5/8" IRON ROD WITH A Y.P.C. MARKED "KEENON LAND SERVICES INC." PER CS No. 4109 N 89°59'24" E 0.21'
- (56) A 5/8" IRON ROD WITH A Y.P.C. MARKED "KEENON LAND SERVICES INC." PER CS No. 4109.
- (153) A 5/8" IRON ROD DOWN 8" PER CS No. 3307 S 6°34'53" E 0.29'
- (155) A 5/8" IRON ROD PER CS No. 3307 S 82°10'50" E 0.21'
- (156) A 5/8" IRON ROD PER CS No. 3307 S 82°10'50" E 0.40'
- (157) A 5/8" IRON ROD PER CS No. L-532 S 88°27'36" E 3.74'
- (158) A 1/2" IRON PIPE S 32°44'41" E 0.55'
- (160) A 5/8" IRON ROD PER CS No. 3307 S 82°10'50" E 0.35'
- (162) A 5/8" IRON ROD WITH A R.P.C. MARKED "BASS PLS 558" PER CS No. 3307 S 82°10'50" E 0.43'
- (164) A 5/8" IRON ROD WITH A R.P.C. MARKED "BASS PLS 558" PER CS No. 3609 S 82°10'50" E 0.83'
- (166) A 5/8" IRON ROD WITH A R.P.C. MARKED "BASS PLS 558" PER CS No. 3609 S 82°10'50" E 0.77'
- (167) A 1/2" IRON PIPE ORIGIN UNKNOWN, S 42°24'59" E 0.60'
- (168) A 5/8" IRON ROD WITH A R.P.C. MARKED "BASS PLS 558" PER CS No. 3609 S 63°05'57" E 0.83'
- (169) A 5/8" IRON ROD PER CS No. L-532, N 73°53'29" E 0.27'
- (170) A 1/2" IRON PIPE S 23°31'57" E 0.55'
- (172) A 1/2" IRON PIPE S 55°46'00" W 5.17'

NARRATIVE:

--THIS SURVEY WAS ACCOMPLISHED AT THE REQUEST OF DONNA TICE TO MONUMENT LOTS 10 & 11, BLOCK 1, CENTRAL ADDITION TO VERNONIA.
--THE BASIS OF BEARINGS IS FROM CS No. 129 BETWEEN THE CENTER LINE MONUMENTS ON BRIDGE STREET AT THE INTERSECTIONS WITH WEED AVENUE AND ADAMS STREET.
--FOR THE BOUNDARY RESOLUTION OF BLOCK 1, CENTRAL ADDITION TO VERNONIA I HELD CS No. 4281.

LEGEND

- = MONUMENT FOUND AS NOTED
- = SET A 5/8" x 30" IRON ROD WITH A Y.P.C. MARKED "KEENON LAND SERVICES INC."
- () = RECORD SURVEY DATA
- CS = RECORD SURVEY No.
- Y.P.C. = YELLOW PLASTIC CAP
- = CONTROL POINT No.

<p>REGISTERED PROFESSIONAL LAND SURVEYOR</p> <p><i>Leslie G. Keenon</i></p> <p>OREGON JULY 30, 1976 LESLIE G. KEENON 1080 RENEWAL DATE 6/30/01</p>	<p>LAND SERVICES</p> <p>KEENON</p> <p>1224 ALDER ST. VERNONIA, OR 97064 (503) 429-6115</p>	<p>SURVEY FOR DONNA TICE IN CENTRAL ADDITION TO VERNONIA, LYING IN THE NW 1/4 OF SECTION 5, T4N, R4W, W.M. COLUMBIA COUNTY, OREGON SCALE 1" = 50' MAY 31, 2000</p>		<p>COLUMBIA COUNTY SURVEYORS OFFICE RECEIVED <u>9/11/00</u> ACCEPTED <u>9/11/00</u> CHECK # <u>473</u></p>
		<p>DRAWN BY: DDW FIELD: MWM/JDB EQUIPMENT: GTS300/TDS48 JOB No. 00-103A PROJECT No. 95-168 REVISED: 5/31/00</p>		

4774

4774