


KEENON LAND SERVICES  
L. JERRY KEENON  
1224 ALDER ST.  
VERNONIA, OREGON 97064  
PH # 429-6115

REGISTERED  
PROFESSIONAL  
LAND SURVEYOR

OREGON  
JULY 30, 1976  
LESLIE G. KEENON  
1080

EXP 6/30/95

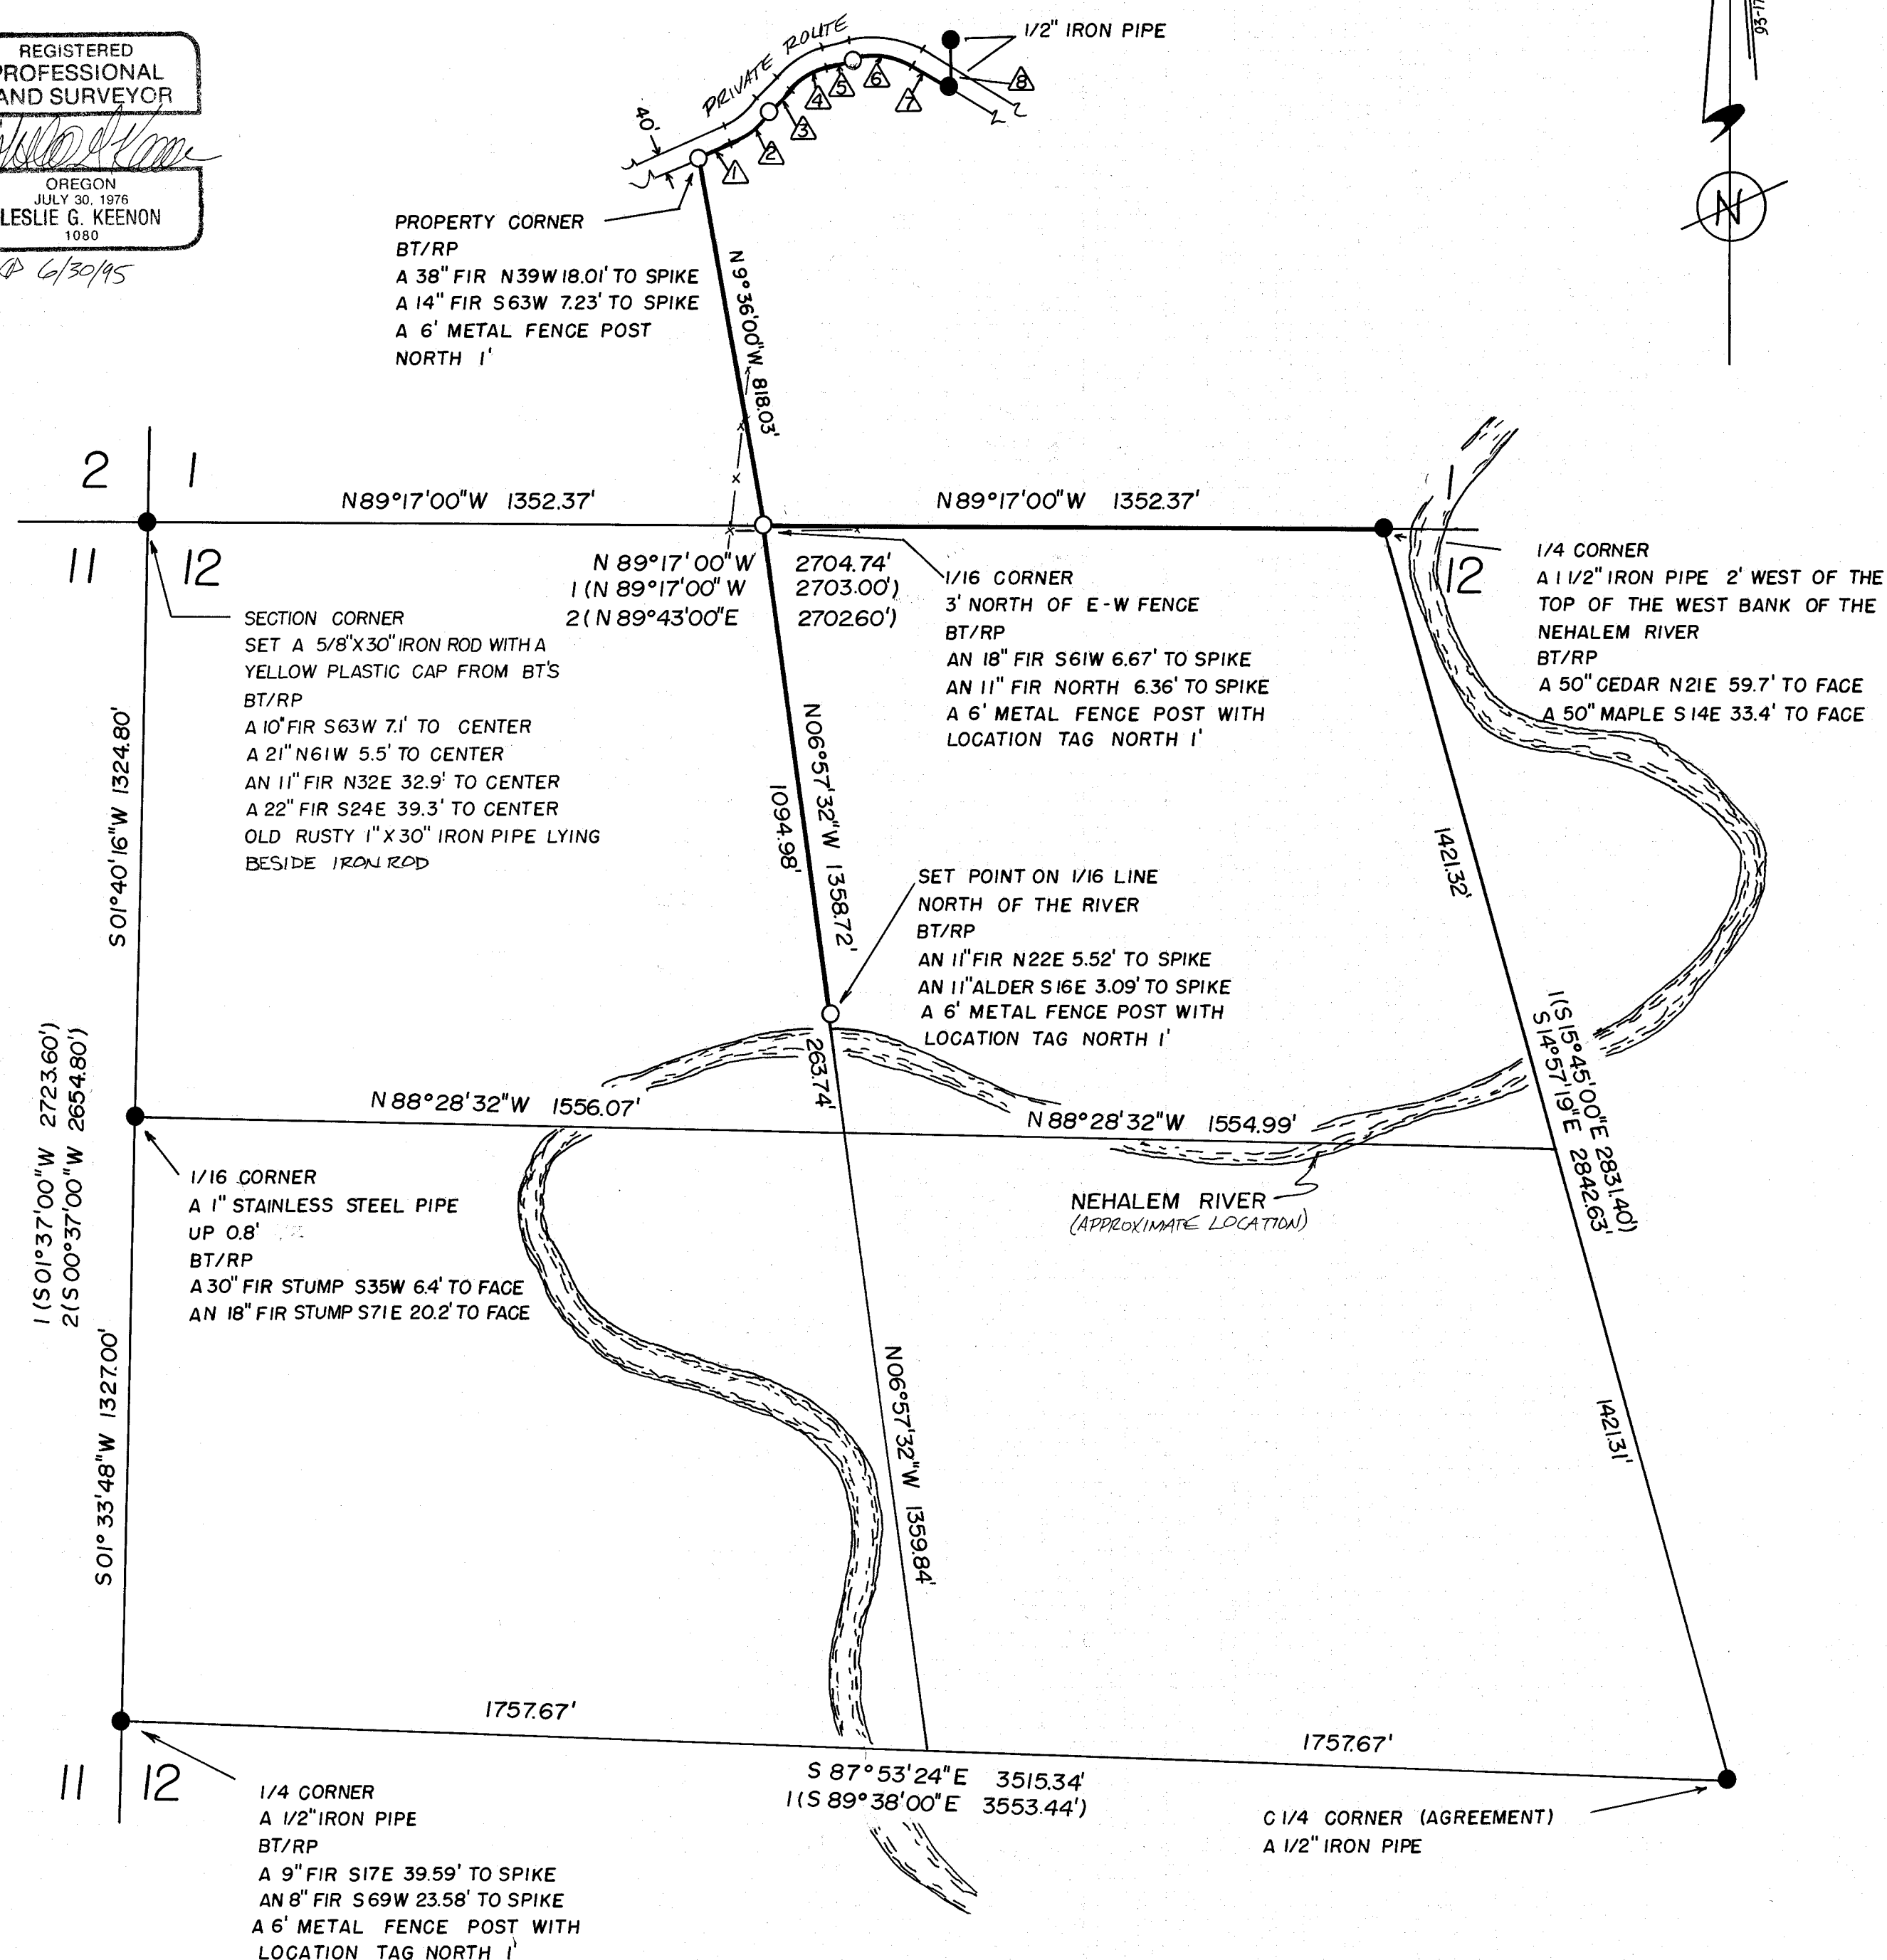

# RECORD OF SURVEY FOR LONGVIEW FIBRE CO. IN THE NW 1/4 OF SEC 12 AND THE SW 1/4 OF SEC. 1, T4N, R5W, W.M. COLUMBIA COUNTY, OREGON SCALE 1"=300' DEC 8, 1993

NARRATIVE: THIS SURVEY WAS CONDUCTED AT THE REQUEST OF LONGVIEW FIBRE CO. TO MARK THE LINES AND MONUMENT THE CORNERS AS SHOWN. THE BASIS OF BEARINGS IS FROM RS 470.

- PROCEDURE
1. I HELD THE MONUMENTS AT THE NW SECTION CORNER AND THE N 1/4 CORNER AS PERPETUATED ORIGINAL CORNERS.
  2. I HELD THE 1/2" IRON PIPE AT THE C 1/4 AS AN AGREEMENT CORNER PER RS 470.
  3. I HELD THE WEST 1/4 CORNER AS PROPORTIONED BY LONGVIEW FIBRE CO. SEE BT BOOK LF PAGE 15 & 42.
  4. I HELD THE DEEDED ANGLE AT THE W 1/16 CORNER AND EXTENDED THE LINE NORTHERLY TO THE SOUTH LINE OF THE 40' WIDE EASEMENT DESCRIBED IN DEED BOOK 112 PAGE 562.
  5. I HELD THE 1/2" IRON PIPE ON THE SOUTH LINE OF THE 40' EASEMENT AND THE DEEDED BEARINGS AND DISTANCES ALONG THE SOUTH LINE OF THE 40' EASEMENT TO THE INTERSECTION WITH THE LINE NORTH FROM THE W 1/16 CORNER.

## LEGEND

- - MONUMENT FOUND AS NOTED
- - SET A 5/8" X 30" IRON ROD WITH A YELLOW PLASTIC CAP MARKED "KEENON LS 1080"
- ( ) - RECORD DATA 1 = RS 470 2 = RS
- RS - COLUMBIA COUNTY RECORD SURVEY No.

## CURVE AND LINE TABLE

	CHORD BRG & DIST	DELTA	RADIUS	ARC
1	N 67°34'42"E 49.51'			
2	N 54°37'12"E 137.45'	25°55'00"	306.48'	138.63'
3	N 41°39'42"E 66.00'			
4	N 58°18'12"E 97.94'	33°17'00"	170.99'	99.33'
5	N 74°56'42"E 58.00'			
6	S 83°37'48"E 124.92'	42°51'00"	170.99'	127.88'
7	S 62°12'18"E 100.00'			
8	N 01°14'42"E 101.08'			

COUNTY SURVEYOR

RECEIVED 1-18-94

FILED 2-23-94

3892