


9007

4006


PROPERTY LINE ADJUSTMENT
FOR DUANE AND SANDE PEARCE
IN THE SW 1/4 OF SEC 3, T4N, R4W, W.M.
COLUMBIA COUNTY, OREGON
SCALE 1" = 30' DEC 8, 1994

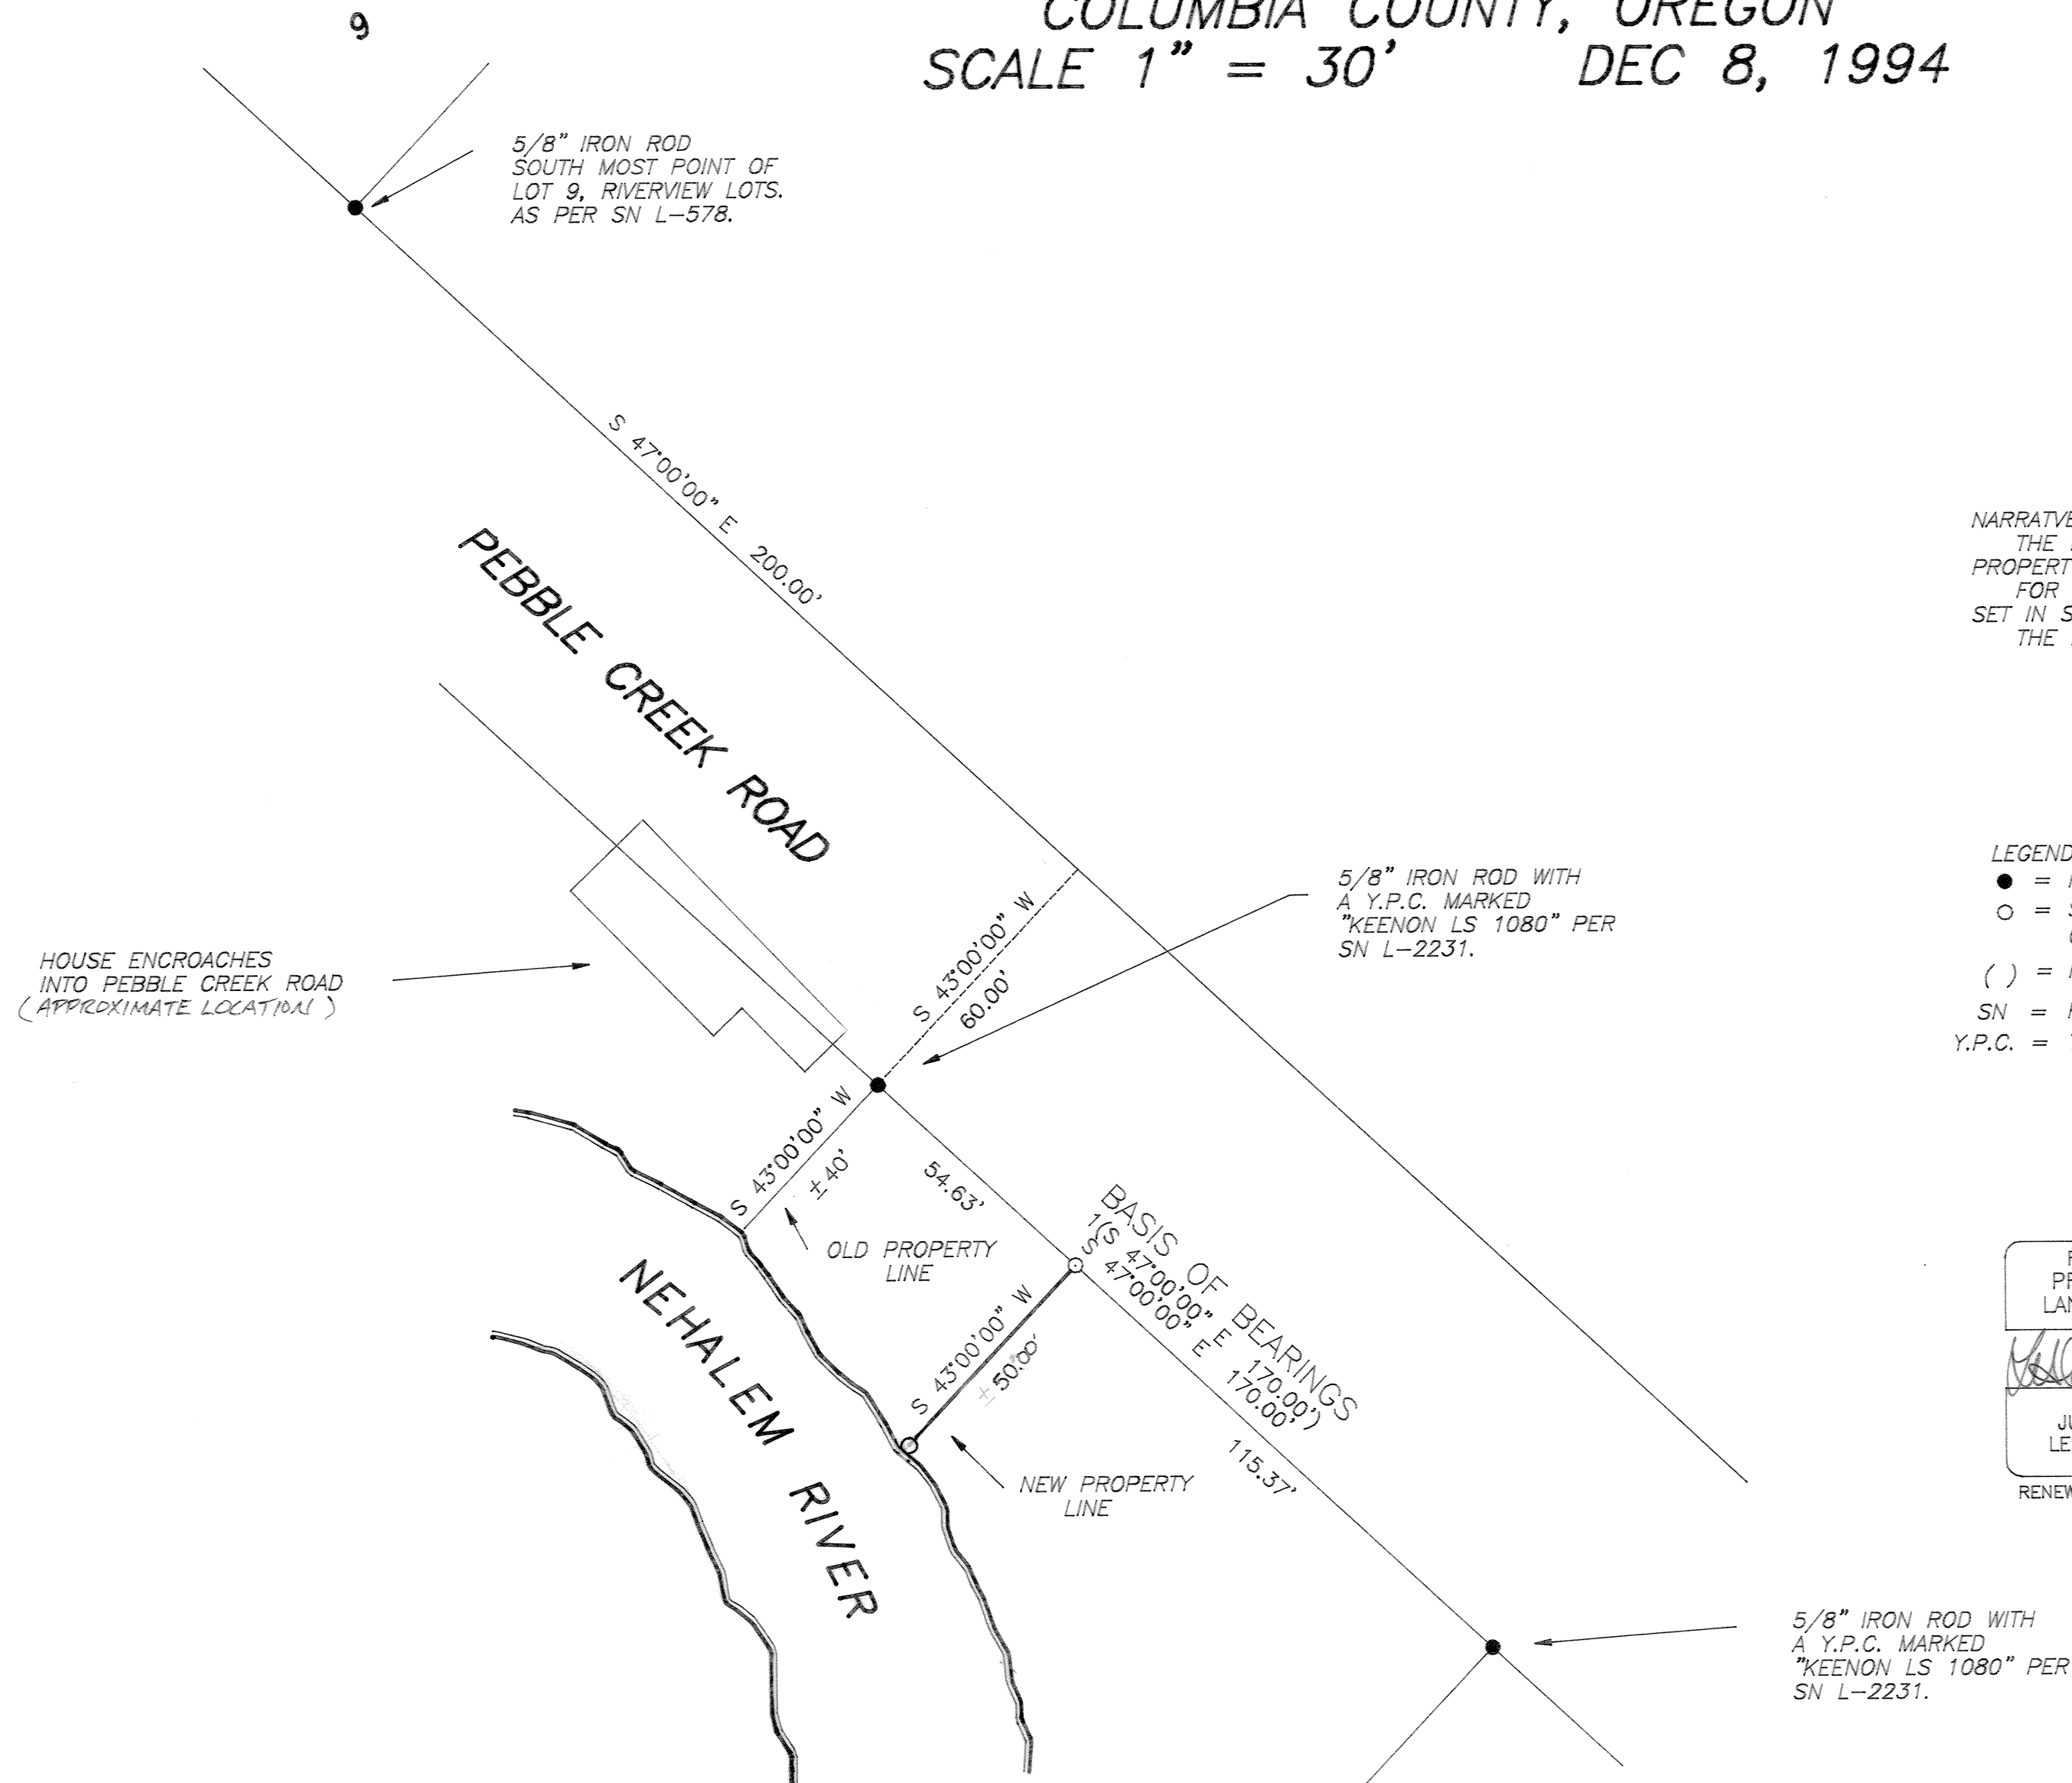

NARRATIVE:
THE PURPOSE OF THIS SURVEY WAS TO MONUMENT A PROPERTY LINE ADJUSTMENT AS SHOWN.
FOR CONTROL I RECOVERED AND HELD THE MONUMENTS SET IN SN L-2231.
THE BASIS OF BEARINGS IS FROM SN L-2231.

LEGEND
● = MONUMENT FOUND AS NOTED
○ = SET A 5/8" X 30" IRON ROD WITH A YELLOW PLASTIC CAP MARKED "KEENON LAND SERVICES INC."
() = RECORD DATA 1 = SN L-2231
SN = RECORD SURVEY NO.
Y.P.C. = YELLOW PLASTIC CAP

REGISTERED
PROFESSIONAL
LAND SURVEYOR
Leslie G. Keenon
OREGON
JULY 30, 1976
LESLIE G. KEENON
1080
RENEWAL DATE 6/30/95

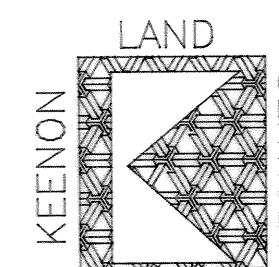

1224 ALDER ST.
VERNONIA, OR
97064
(503) 429-6115

COLUMBIA COUNTY SURVEYORS OFFICE
RECIEVED 12-13-94
ACCEPTED FOR FILING 1-26-95

4006