


1445

5441

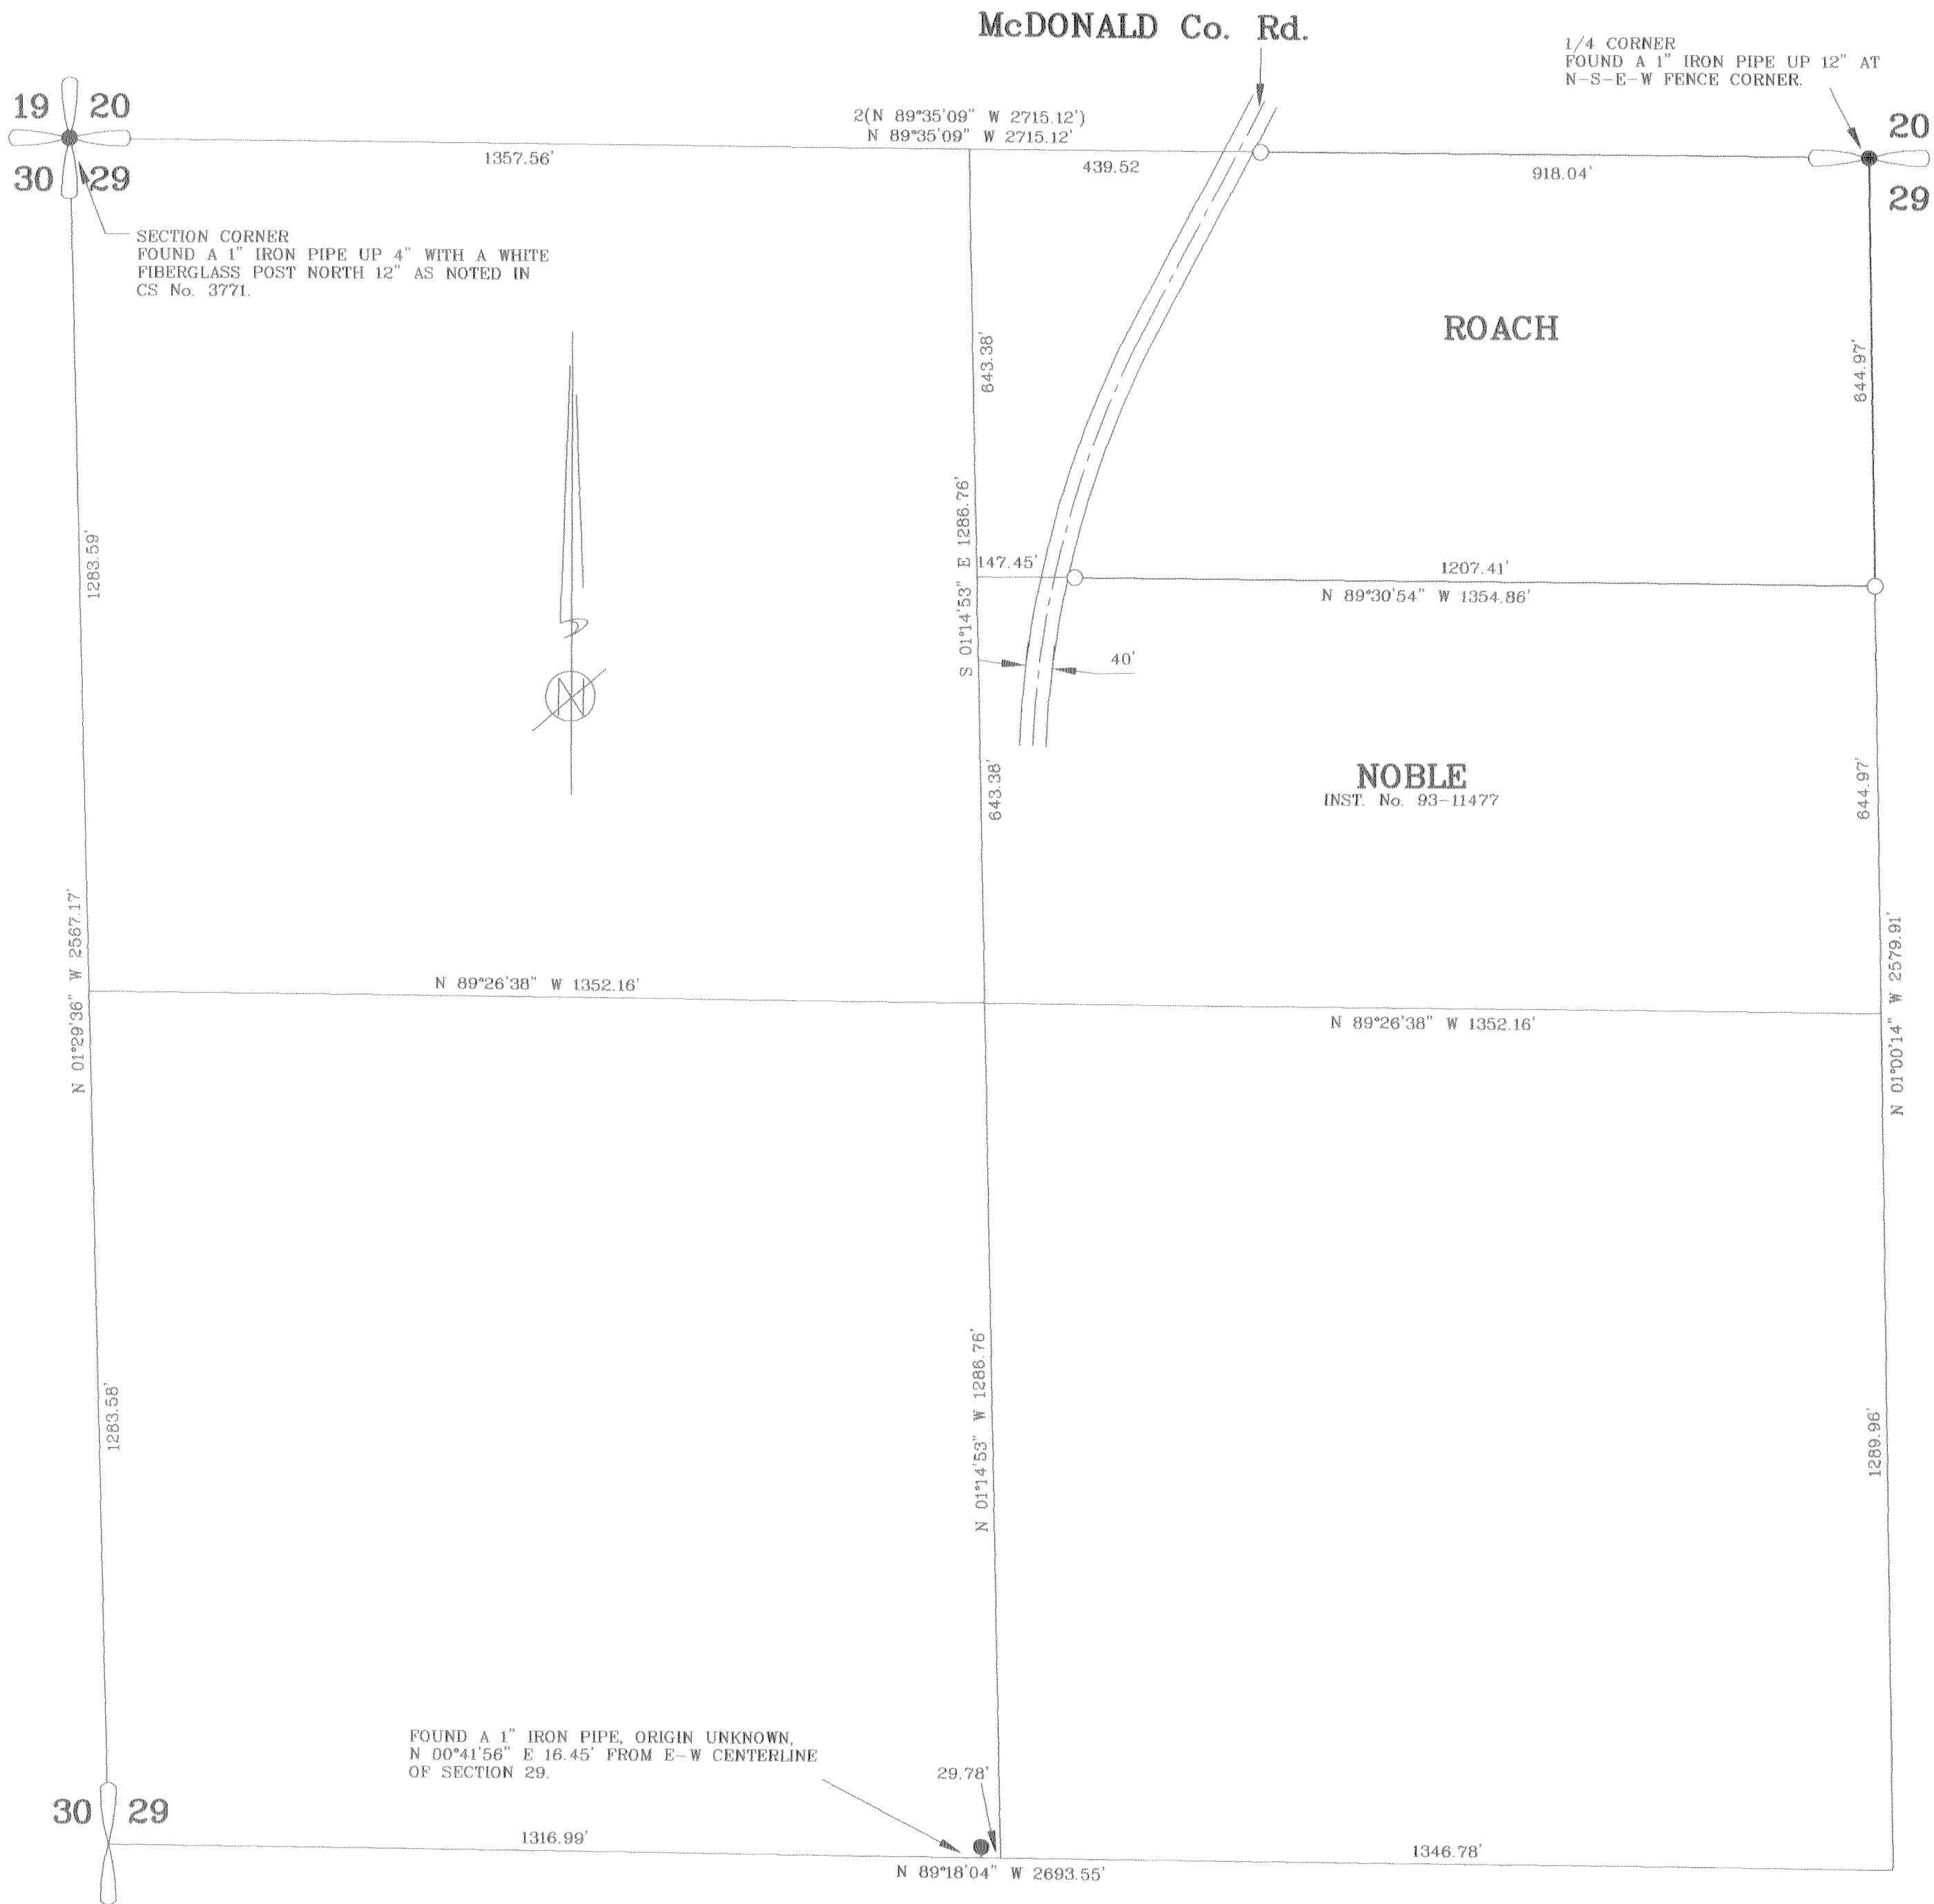

LEGEND

- = MONUMENT FOUND AS NOTED
- = SET A 5/8" x 30" IRON ROD WITH A Y.P.C.
MARKED "KEENON LAND SERVICES INC."
- () = RECORD SURVEY DATA
- [] = RECORD DEED DATA
- CS No. = RECORD SURVEY No.
- Y.P.C. = YELLOW PLASTIC CAP
- = CONTROL POINT No.


NARRATIVE:

--THIS SURVEY WAS ACCOMPLISHED AT THE REQUEST OF DANA ROACH TO MARK AND MONUMENT THAT TRACT OF LAND DESCRIBED IN CLERKS INSTRUMENT 94-11300, COLUMBIA COUNTY RECORDS, BEING THE NORTH 1/2 OF THE NE 1/4 OF THE NW 1/4 OF SECTION 29, T4N, R4W, W.M.

--THE BASIS OF BEARINGS IS THE NORTH LINE OF THE NW 1/4 FROM CS No. 3771.



--FOR CONTROL I HELD THE SUBDIVISION OF SECTION 29 PER CS No. 3771. I HELD THE RECORD DATA PER CS No. 3771 TO COMPUTED THE LOCATION OF THE W 1/4 AND THE C 1/4 AND SUBDIVIDED THE NW 1/4 ACCORDING TO THE 1973 B.L.M. MANUAL OF SURVEYING INSTRUCTIONS.

* NOTE: THIS SURVEY DISCOVERED AS NOT IN CS RECORDS.
THOUGH COMPLETED IN 2000, IT IS BEING RECORDED IN 2007.

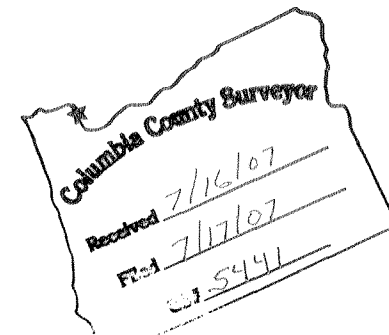

REFERENCE SURVEYS

- 1 = CS No. 3563
- 2 = CS No. 3771
- 3 = CS No. B-193

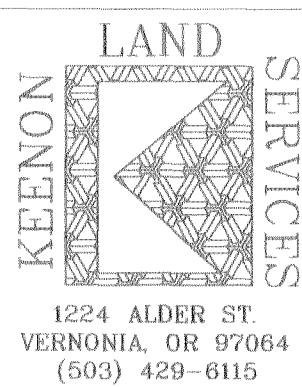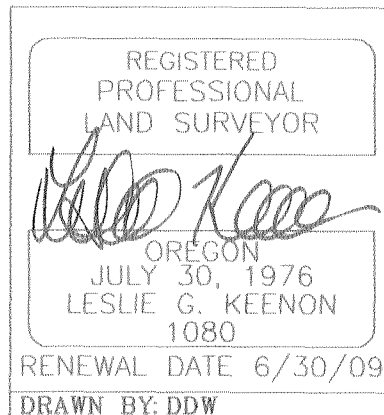

SURVEY FOR

DANA ROACH
IN THE NW 1/4 OF SECTION 29,
T4N, R4W, W.M.
COLUMBIA COUNTY, OREGON
SCALE 1" = 200' NOV 6, 2000 *

COLUMBIA COUNTY
SURVEYORS OFFICE
RECEIVED _____
ACCEPTED _____
CHECK # _____

DRAWN BY: DDW

FIELD: MWM/JDB

EQUIPMENT: GTS300/TDS48

JOB No. 00-156

PROJECT No. 00-156

REVISED: 12/12/00

5441

5441