


4447

4447

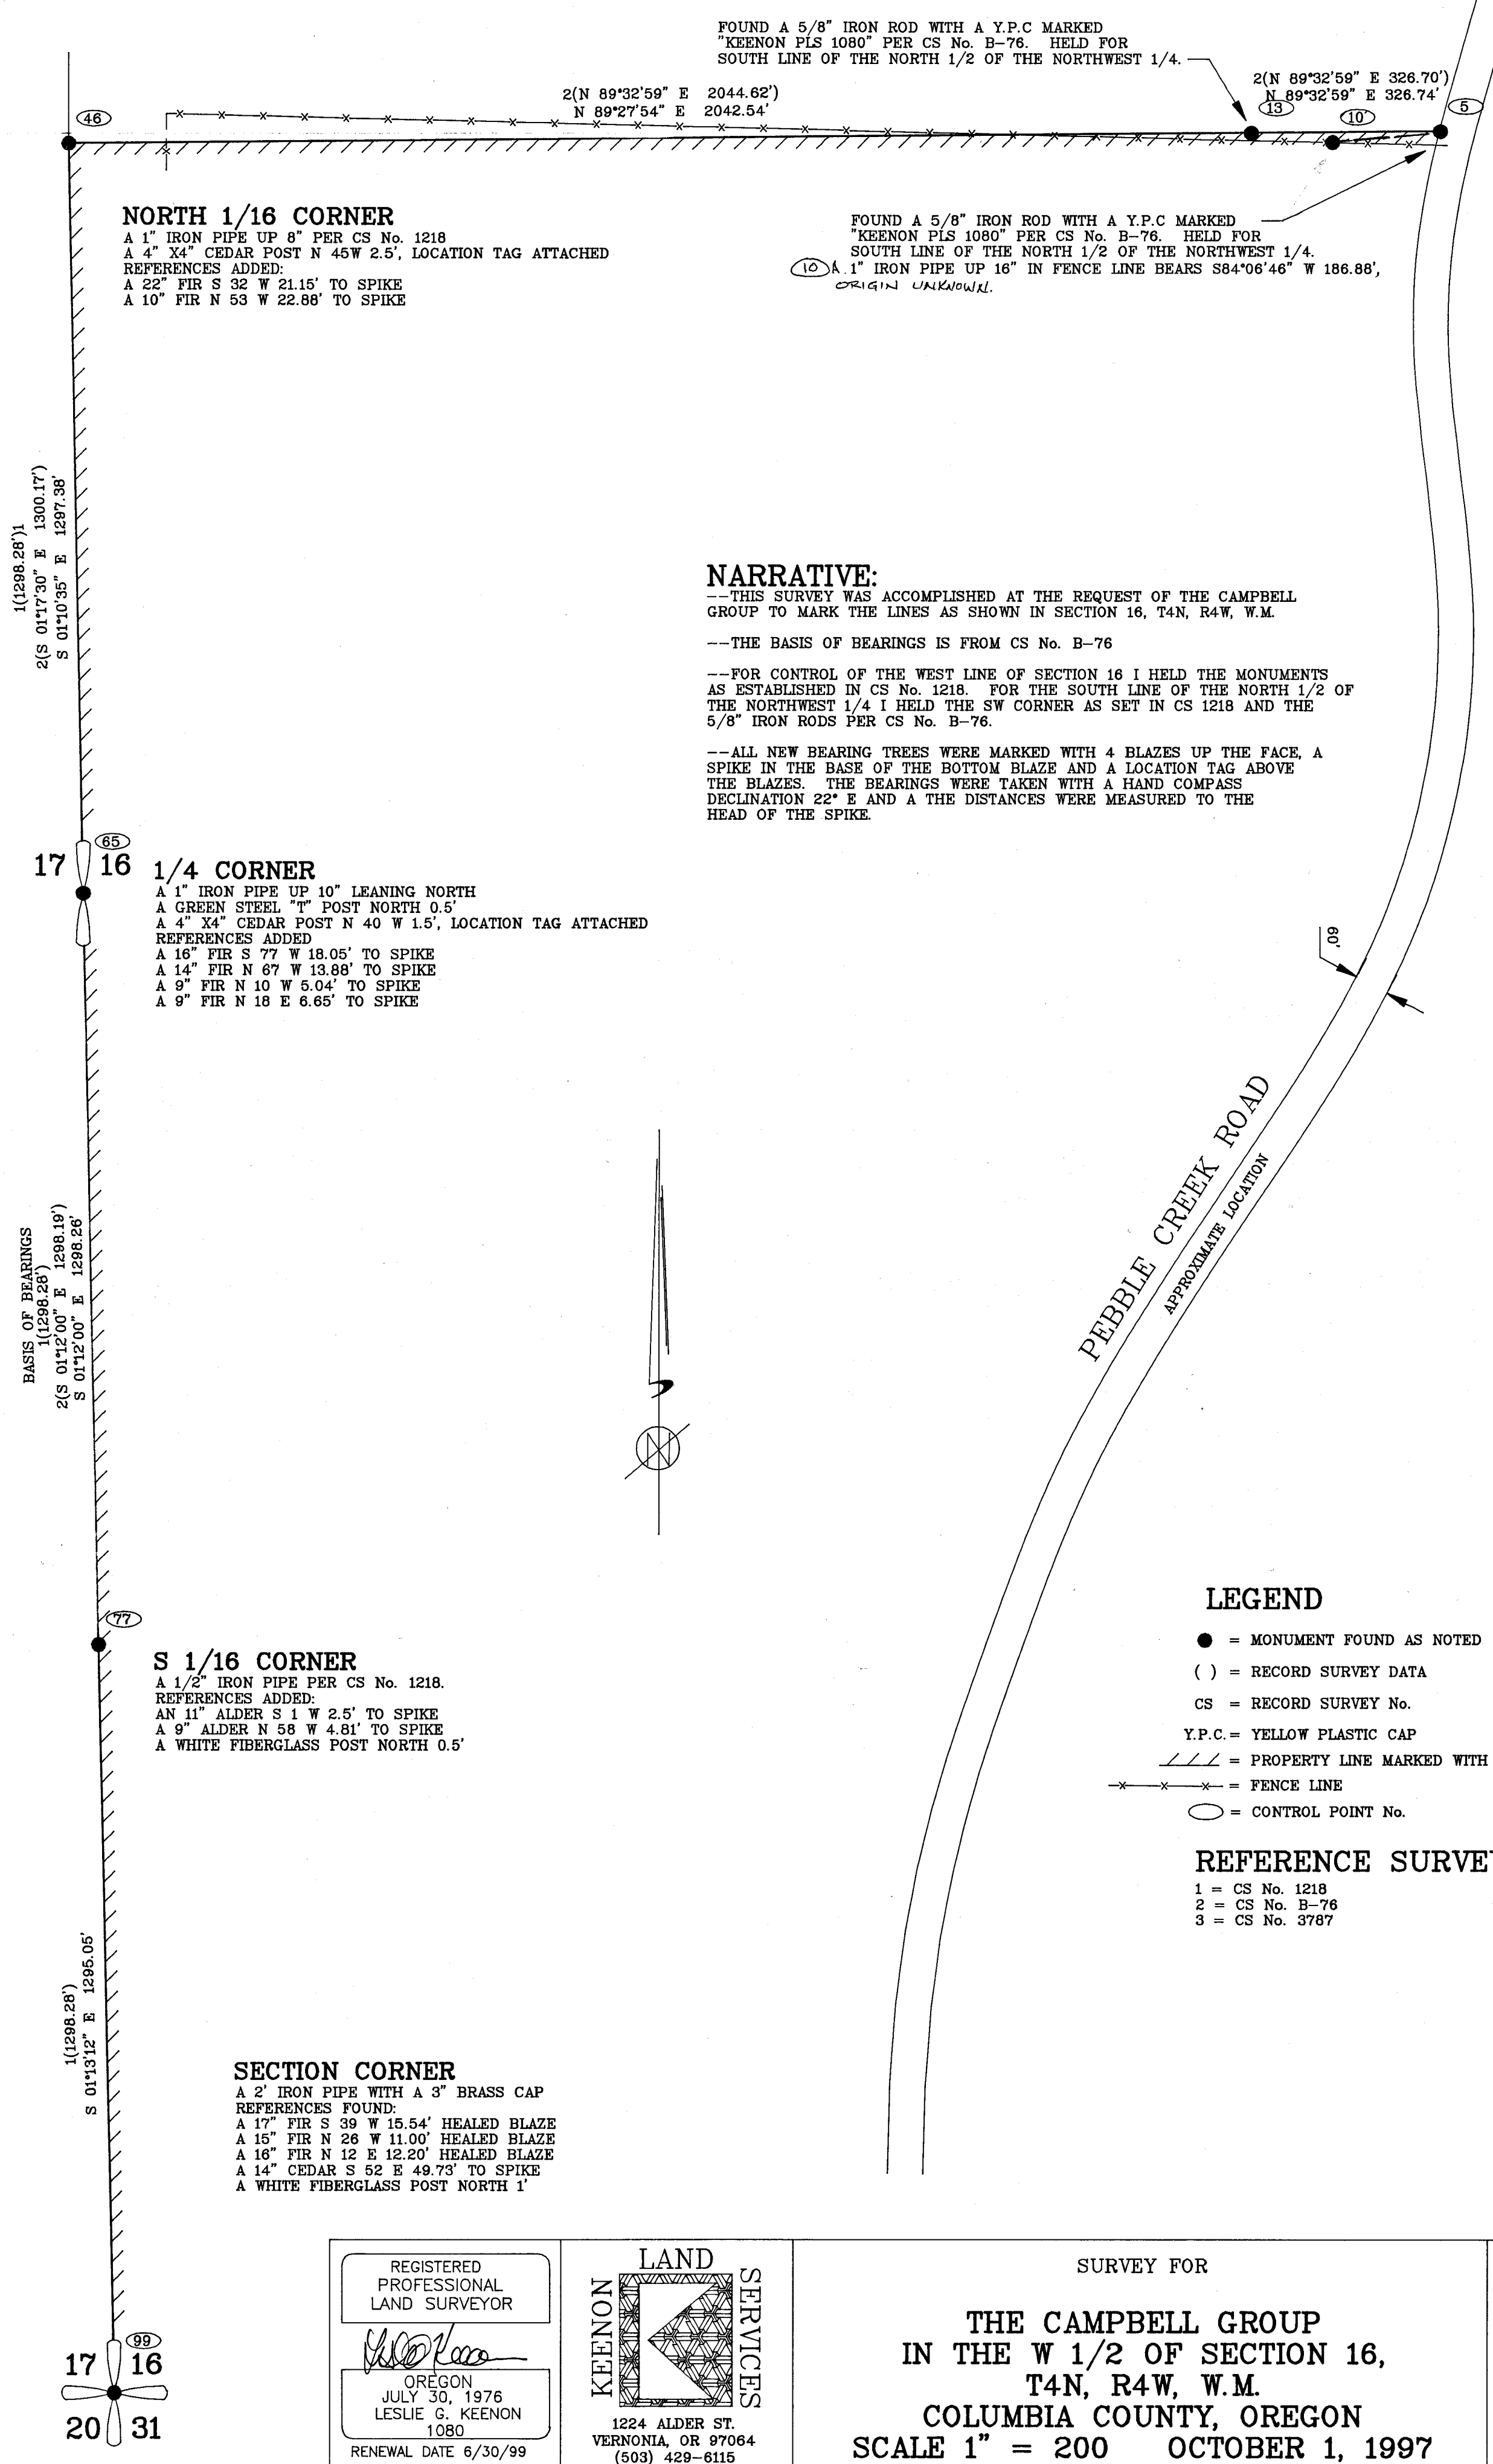

NORTH 1/16 CORNER
A 1" IRON PIPE UP 8" PER CS No. 1218
A 4" X4" CEDAR POST N 45° W 2.5', LOCATION TAG ATTACHED
REFERENCES ADDED:
A 22" FIR S 32° W 21.15' TO SPIKE
A 10" FIR N 53° W 22.88' TO SPIKE

FOUND A 5/8" IRON ROD WITH A Y.P.C MARKED
"KEENON PLS 1080" PER CS No. B-76. HELD FOR
SOUTH LINE OF THE NORTH 1/2 OF THE NORTHWEST 1/4.

2(N 89°32'59" E 2044.62')
N 89°32'59" E 2042.54'

FOUND A 5/8" IRON ROD WITH A Y.P.C MARKED
"KEENON PLS 1080" PER CS No. B-76. HELD FOR
SOUTH LINE OF THE NORTH 1/2 OF THE NORTHWEST 1/4.
A 1" IRON PIPE UP 16" IN FENCE LINE BEARS S84°06'46" W 186.88',
ORIGIN UNKNOWN.

NARRATIVE:

--THIS SURVEY WAS ACCOMPLISHED AT THE REQUEST OF THE CAMPBELL GROUP TO MARK THE LINES AS SHOWN IN SECTION 16, T4N, R4W, W.M.

--THE BASIS OF BEARINGS IS FROM CS No. B-76

--FOR CONTROL OF THE WEST LINE OF SECTION 16 I HELD THE MONUMENTS AS ESTABLISHED IN CS No. 1218. FOR THE SOUTH LINE OF THE NORTH 1/2 OF THE NORTHWEST 1/4 I HELD THE SW CORNER AS SET IN CS 1218 AND THE 5/8" IRON RODS PER CS No. B-76.

--ALL NEW BEARING TREES WERE MARKED WITH 4 BLAZES UP THE FACE, A SPIKE IN THE BASE OF THE BOTTOM BLAZE AND A LOCATION TAG ABOVE THE BLAZES. THE BEARINGS WERE TAKEN WITH A HAND COMPASS DECLINATION 22° E AND A THE DISTANCES WERE MEASURED TO THE HEAD OF THE SPIKE.

16 1/4 CORNER
A 1" IRON PIPE UP 10" LEANING NORTH
A GREEN STEEL "T" POST NORTH 0.5'
A 4" X4" CEDAR POST N 40° W 1.5', LOCATION TAG ATTACHED
REFERENCES ADDED:
A 16" FIR S 77° W 18.05' TO SPIKE
A 14" FIR N 67° W 13.88' TO SPIKE
A 9" FIR N 10° W 5.04' TO SPIKE
A 9" FIR N 18° E 6.65' TO SPIKE

BASIS OF BEARINGS
1(1298.28')
2(S 01°12'00" E 1298.19')
S 01°12'00" E 1298.26'

S 1/16 CORNER
A 1/2" IRON PIPE PER CS No. 1218.
REFERENCES ADDED:
AN 11" ALDER S 1° W 2.5' TO SPIKE
A 9" ALDER N 58° W 4.81' TO SPIKE
A WHITE FIBERGLASS POST NORTH 0.5'

SECTION CORNER
A 2" IRON PIPE WITH A 3" BRASS CAP
REFERENCES FOUND:
A 17" FIR S 39° W 15.54' HEALED BLAZE
A 15" FIR N 26° W 11.00' HEALED BLAZE
A 16" FIR N 12° E 12.20' HEALED BLAZE
A 14" CEDAR S 52° E 49.73' TO SPIKE
A WHITE FIBERGLASS POST NORTH 1'

LEGEND

- = MONUMENT FOUND AS NOTED
- () = RECORD SURVEY DATA
- CS = RECORD SURVEY No.
- Y.P.C. = YELLOW PLASTIC CAP
- /// = PROPERTY LINE MARKED WITH RED AND WHITE RIBBON
- x-x-x- = FENCE LINE
- = CONTROL POINT No.

REFERENCE SURVEYS

- 1 = CS No. 1218
- 2 = CS No. B-76
- 3 = CS No. 3787

<p>REGISTERED PROFESSIONAL LAND SURVEYOR</p> <p><i>Leslie G. Keenon</i></p> <p>OREGON JULY 30, 1976 LESLIE G. KEENON 1080 RENEWAL DATE 6/30/99</p>	<p>KEENON LAND SERVICES</p> <p>1224 ALDER ST. VERNONIA, OR 97064 (503) 429-6115</p>	<p>SURVEY FOR</p> <p>THE CAMPBELL GROUP IN THE W 1/2 OF SECTION 16, T4N, R4W, W.M. COLUMBIA COUNTY, OREGON SCALE 1" = 200 OCTOBER 1, 1997</p>		<p>COLUMBIA COUNTY SURVEYORS OFFICE RECEIVED 10/3/97 ACCEPTED <i>2-4-98</i> CHECK # 200</p>	
		<p>DRAWN BY: VSS</p>	<p>FIELD: MM/SD</p>		<p>EQUIPMENT: GTS300/TDS48</p>

4447

4417