



6847

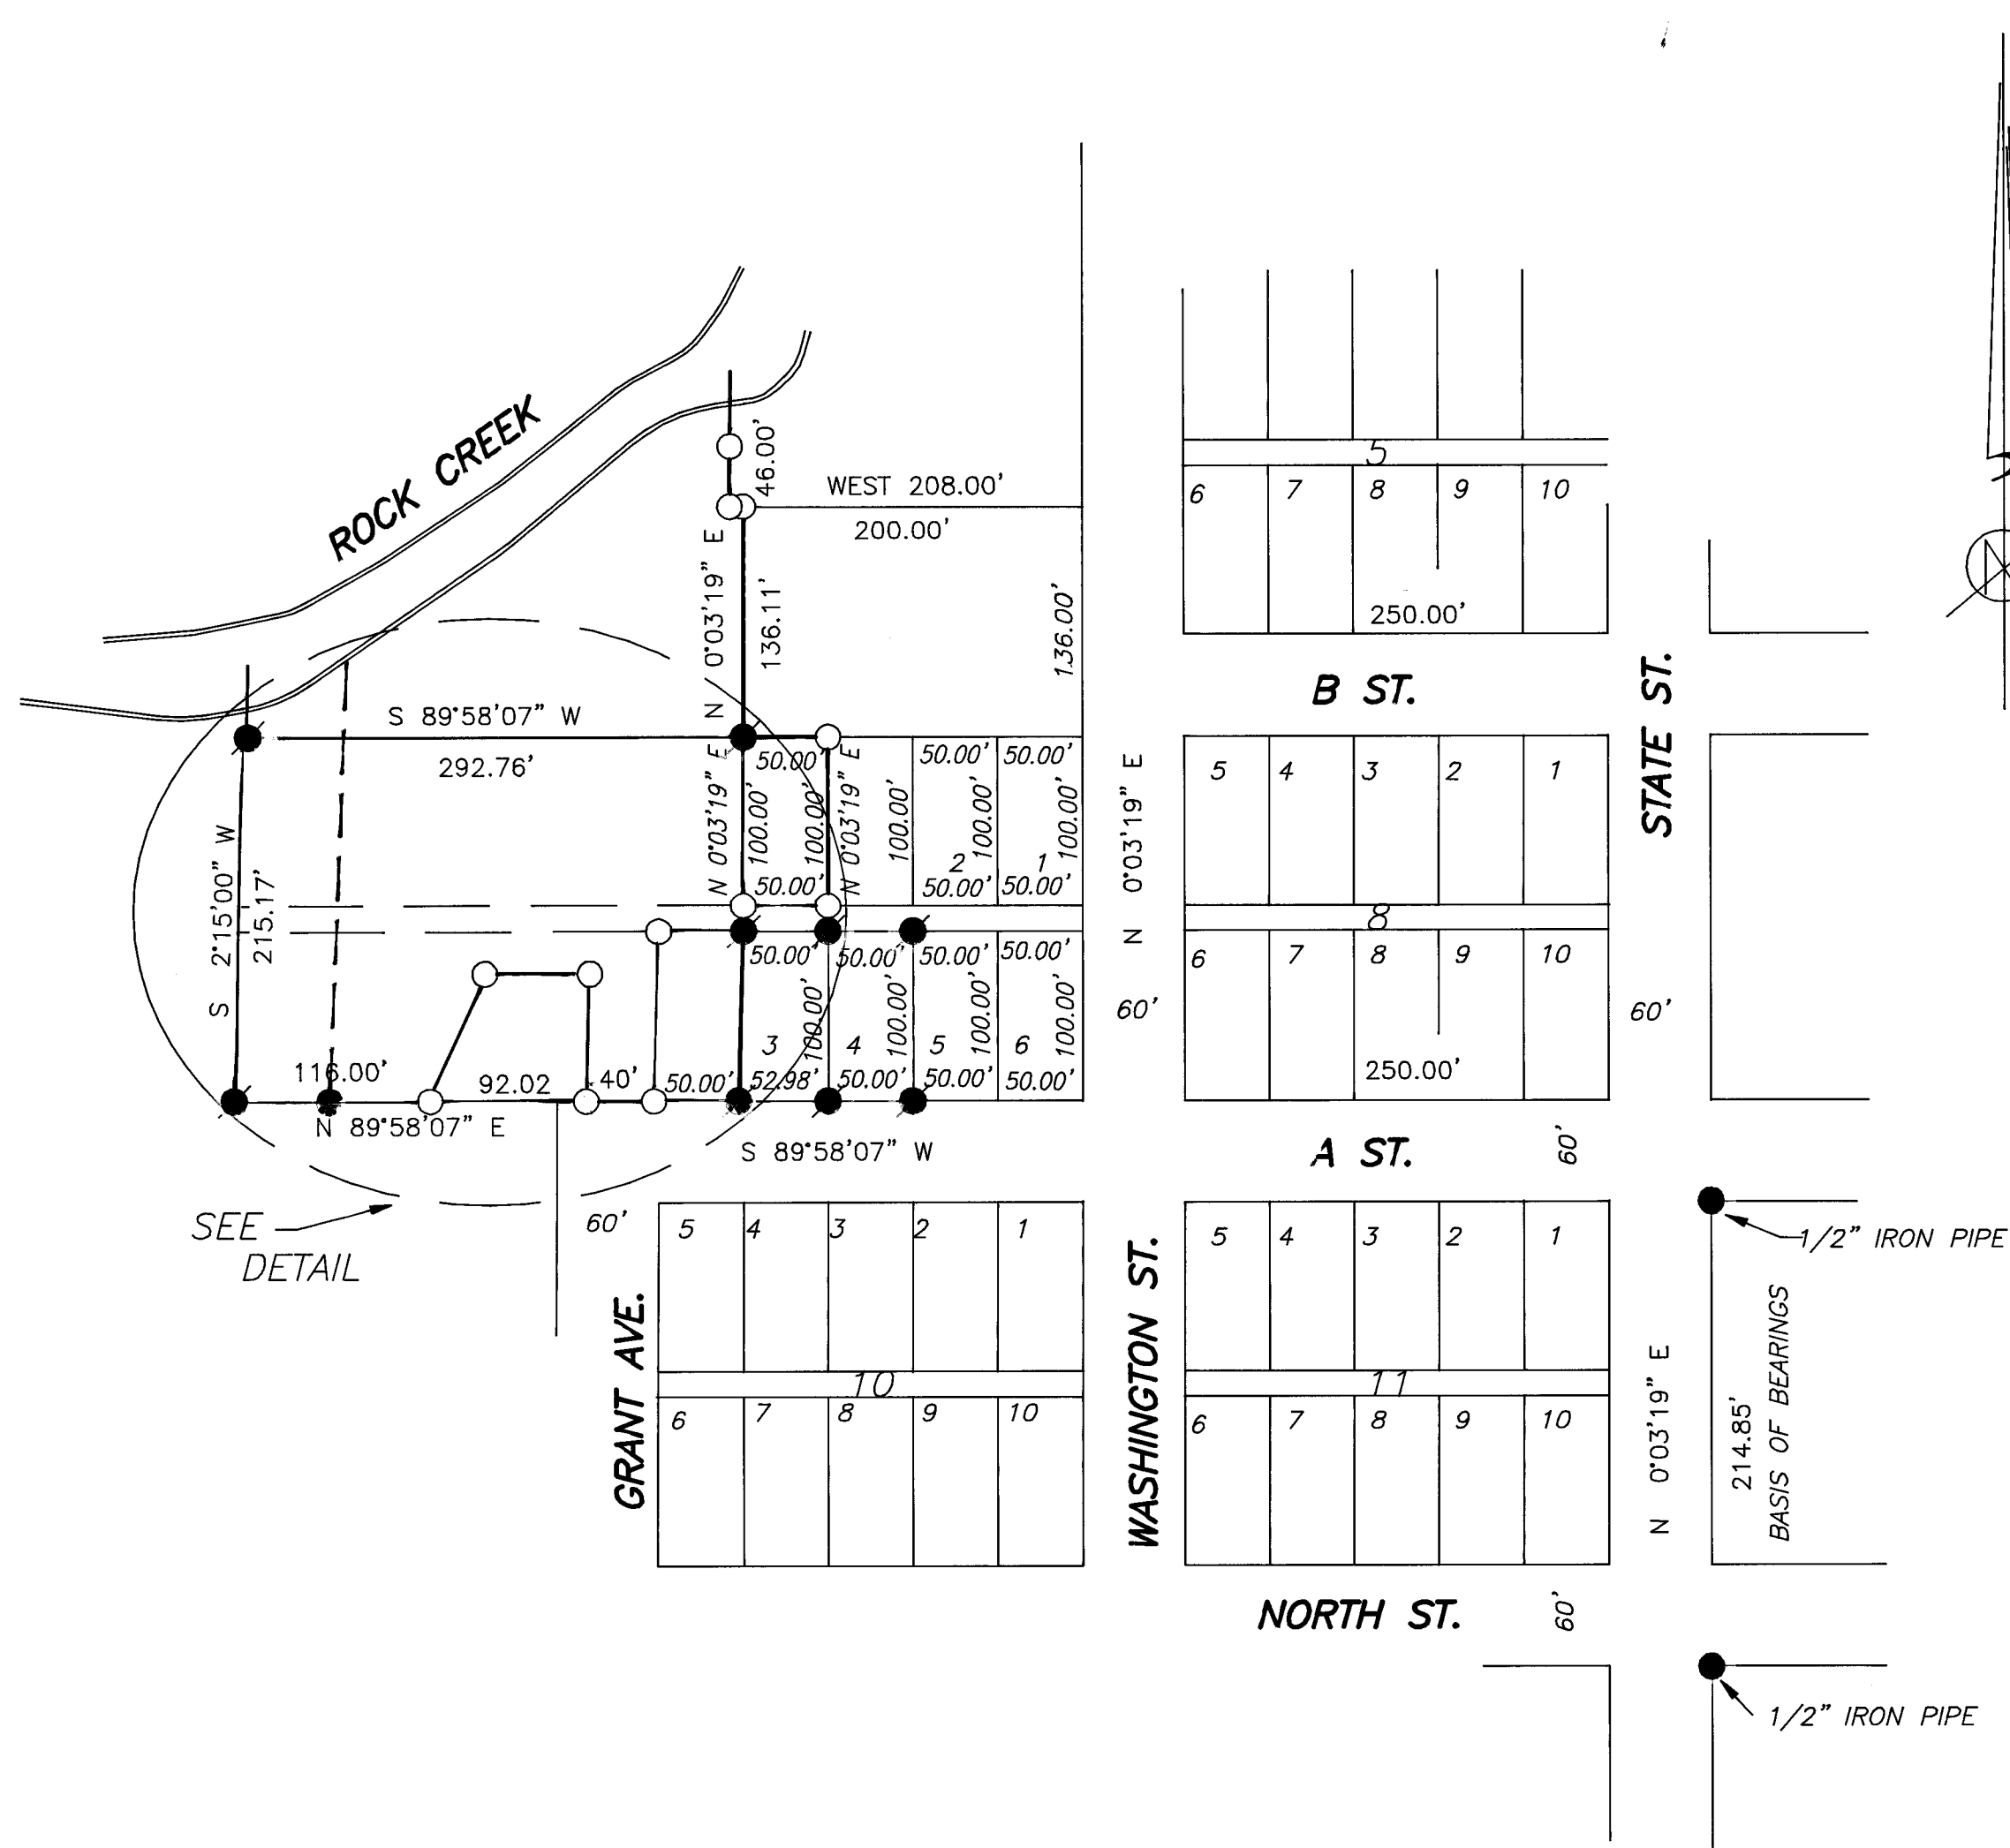

THIS SURVEY WAS ACCOMPLISHED AT THE REQUEST OF SAM WATERS AND RICH DURBIN TO MONUMENT A PROPERTY LINE ADJUSTMENT ON THAT TRACT AS DESCRIBED IN DEED BOOK 93-7085. THE NEW LINES WERE DETERMINED BY MR. WATERS AND MONUMENTED AS SHOWN. THE BOUNDARY OF THE TRACT WAS HELD AS MONUMENTED IN CS No. 3988. THE BASIS OF BEARINGS IS FROM CS No. 3806

# LEGEND


- = FOUND A 5/8" X 30" IRON ROD WITH A Y.P.C. MARKED "KEENON LS 1080" PER CS No. 3988
- = MONUMENT FOUND AS NOTED
- = SET A 5/8" X 30" IRON ROD WITH A Y.P.C. MARKED "KEENON LS 1080"
- ( ) = RECORD DATA, PLAT OF EASTSIDE ADDITION
- CS = RECORD SURVEY NO.

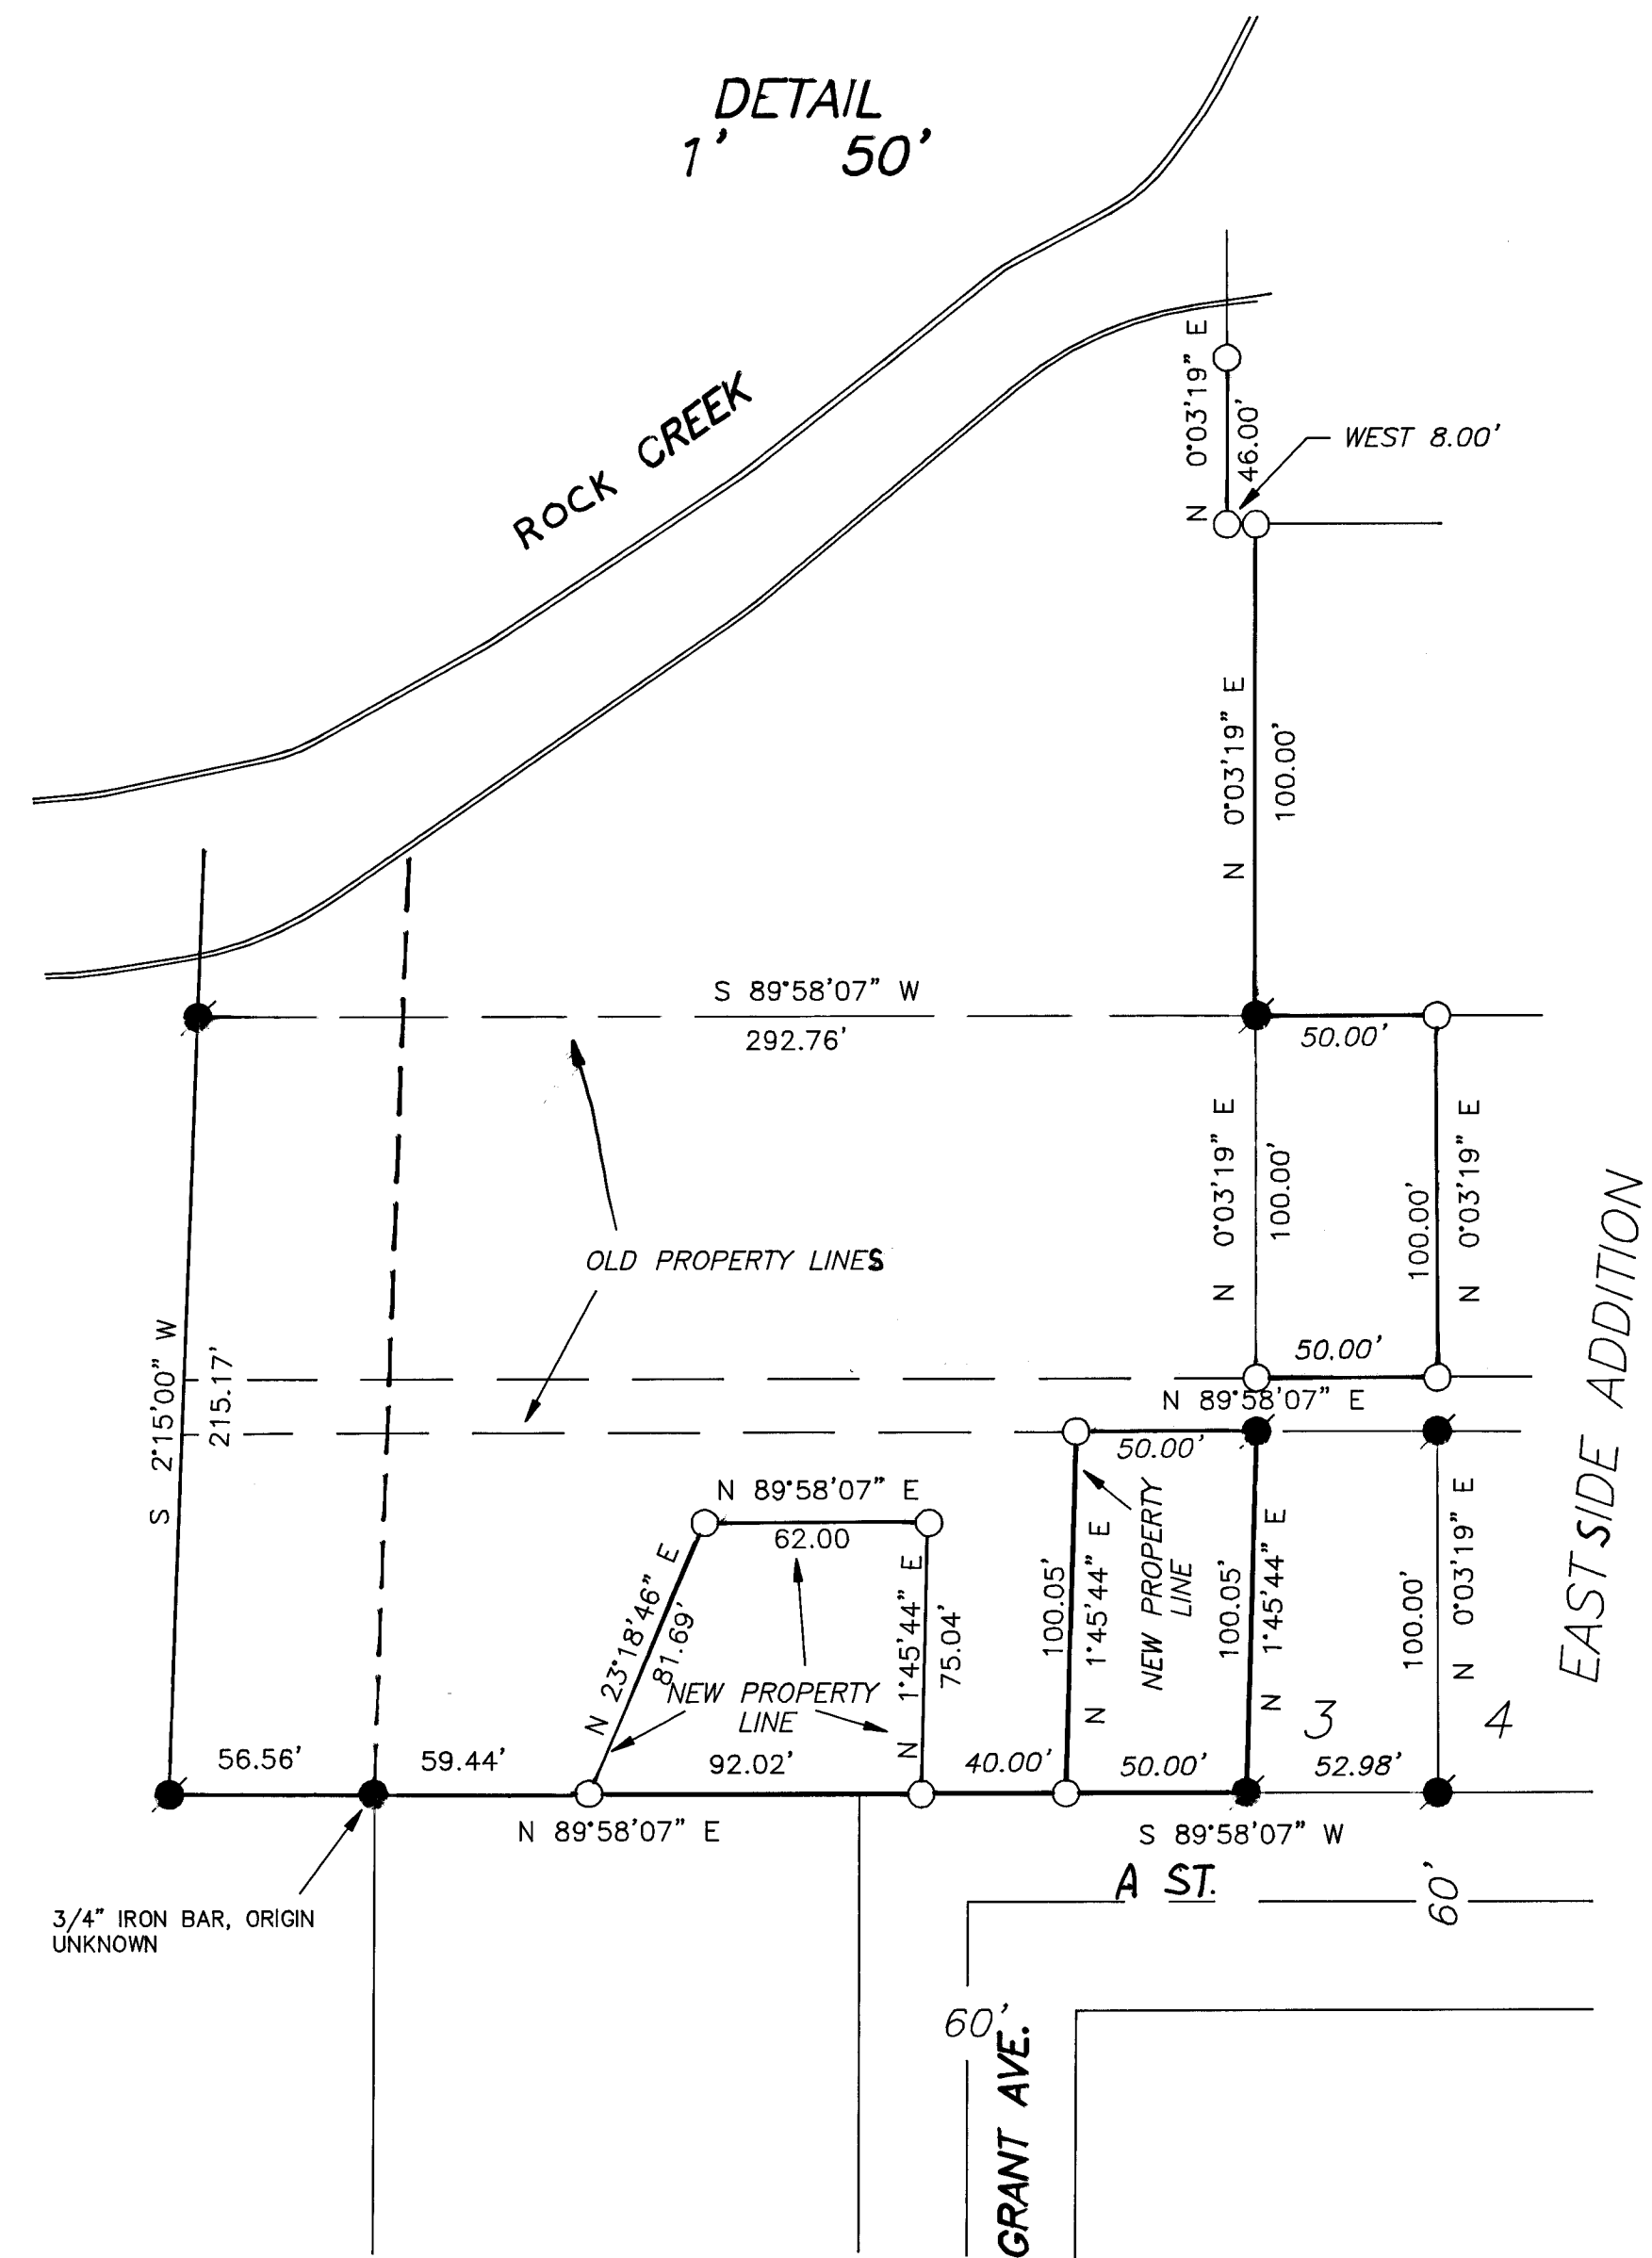

PROPERTY LINE ADJUSTMENT  
FOR SAM WATERS AND RICH DURBIN  
IN THE EASTSIDE ADDITION TO VERNONIA,  
IN THE NE 1/4 OF SEC 4, T4N, R4W, W.M.  
COLUMBIA COUNTY, OREGON  
SCALE 1" = 100' AUG 23, 1996

REGISTERED  
PROFESSIONAL  
LAND SURVEYOR

LESLIE G. KEENON  
JULY 30, 1976  
RENEWAL DATE 6/30/97

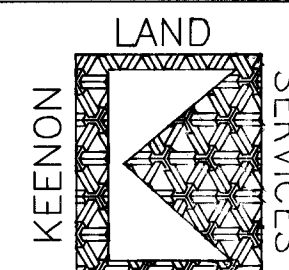

1224 ALDER ST.  
VERNONIA, OR  
97064  
(503) 429-6115

COLUMBIA COUNTY SURVEYORS OFFICE  
RECIEVED 11-18-96  
ACCEPTED FOR FILING 12-18-96  
CHECK No. 123

DRAWN BY: DON W CHECKED BY: REVISED: 9/20/96 JOB No. 94-197

4187