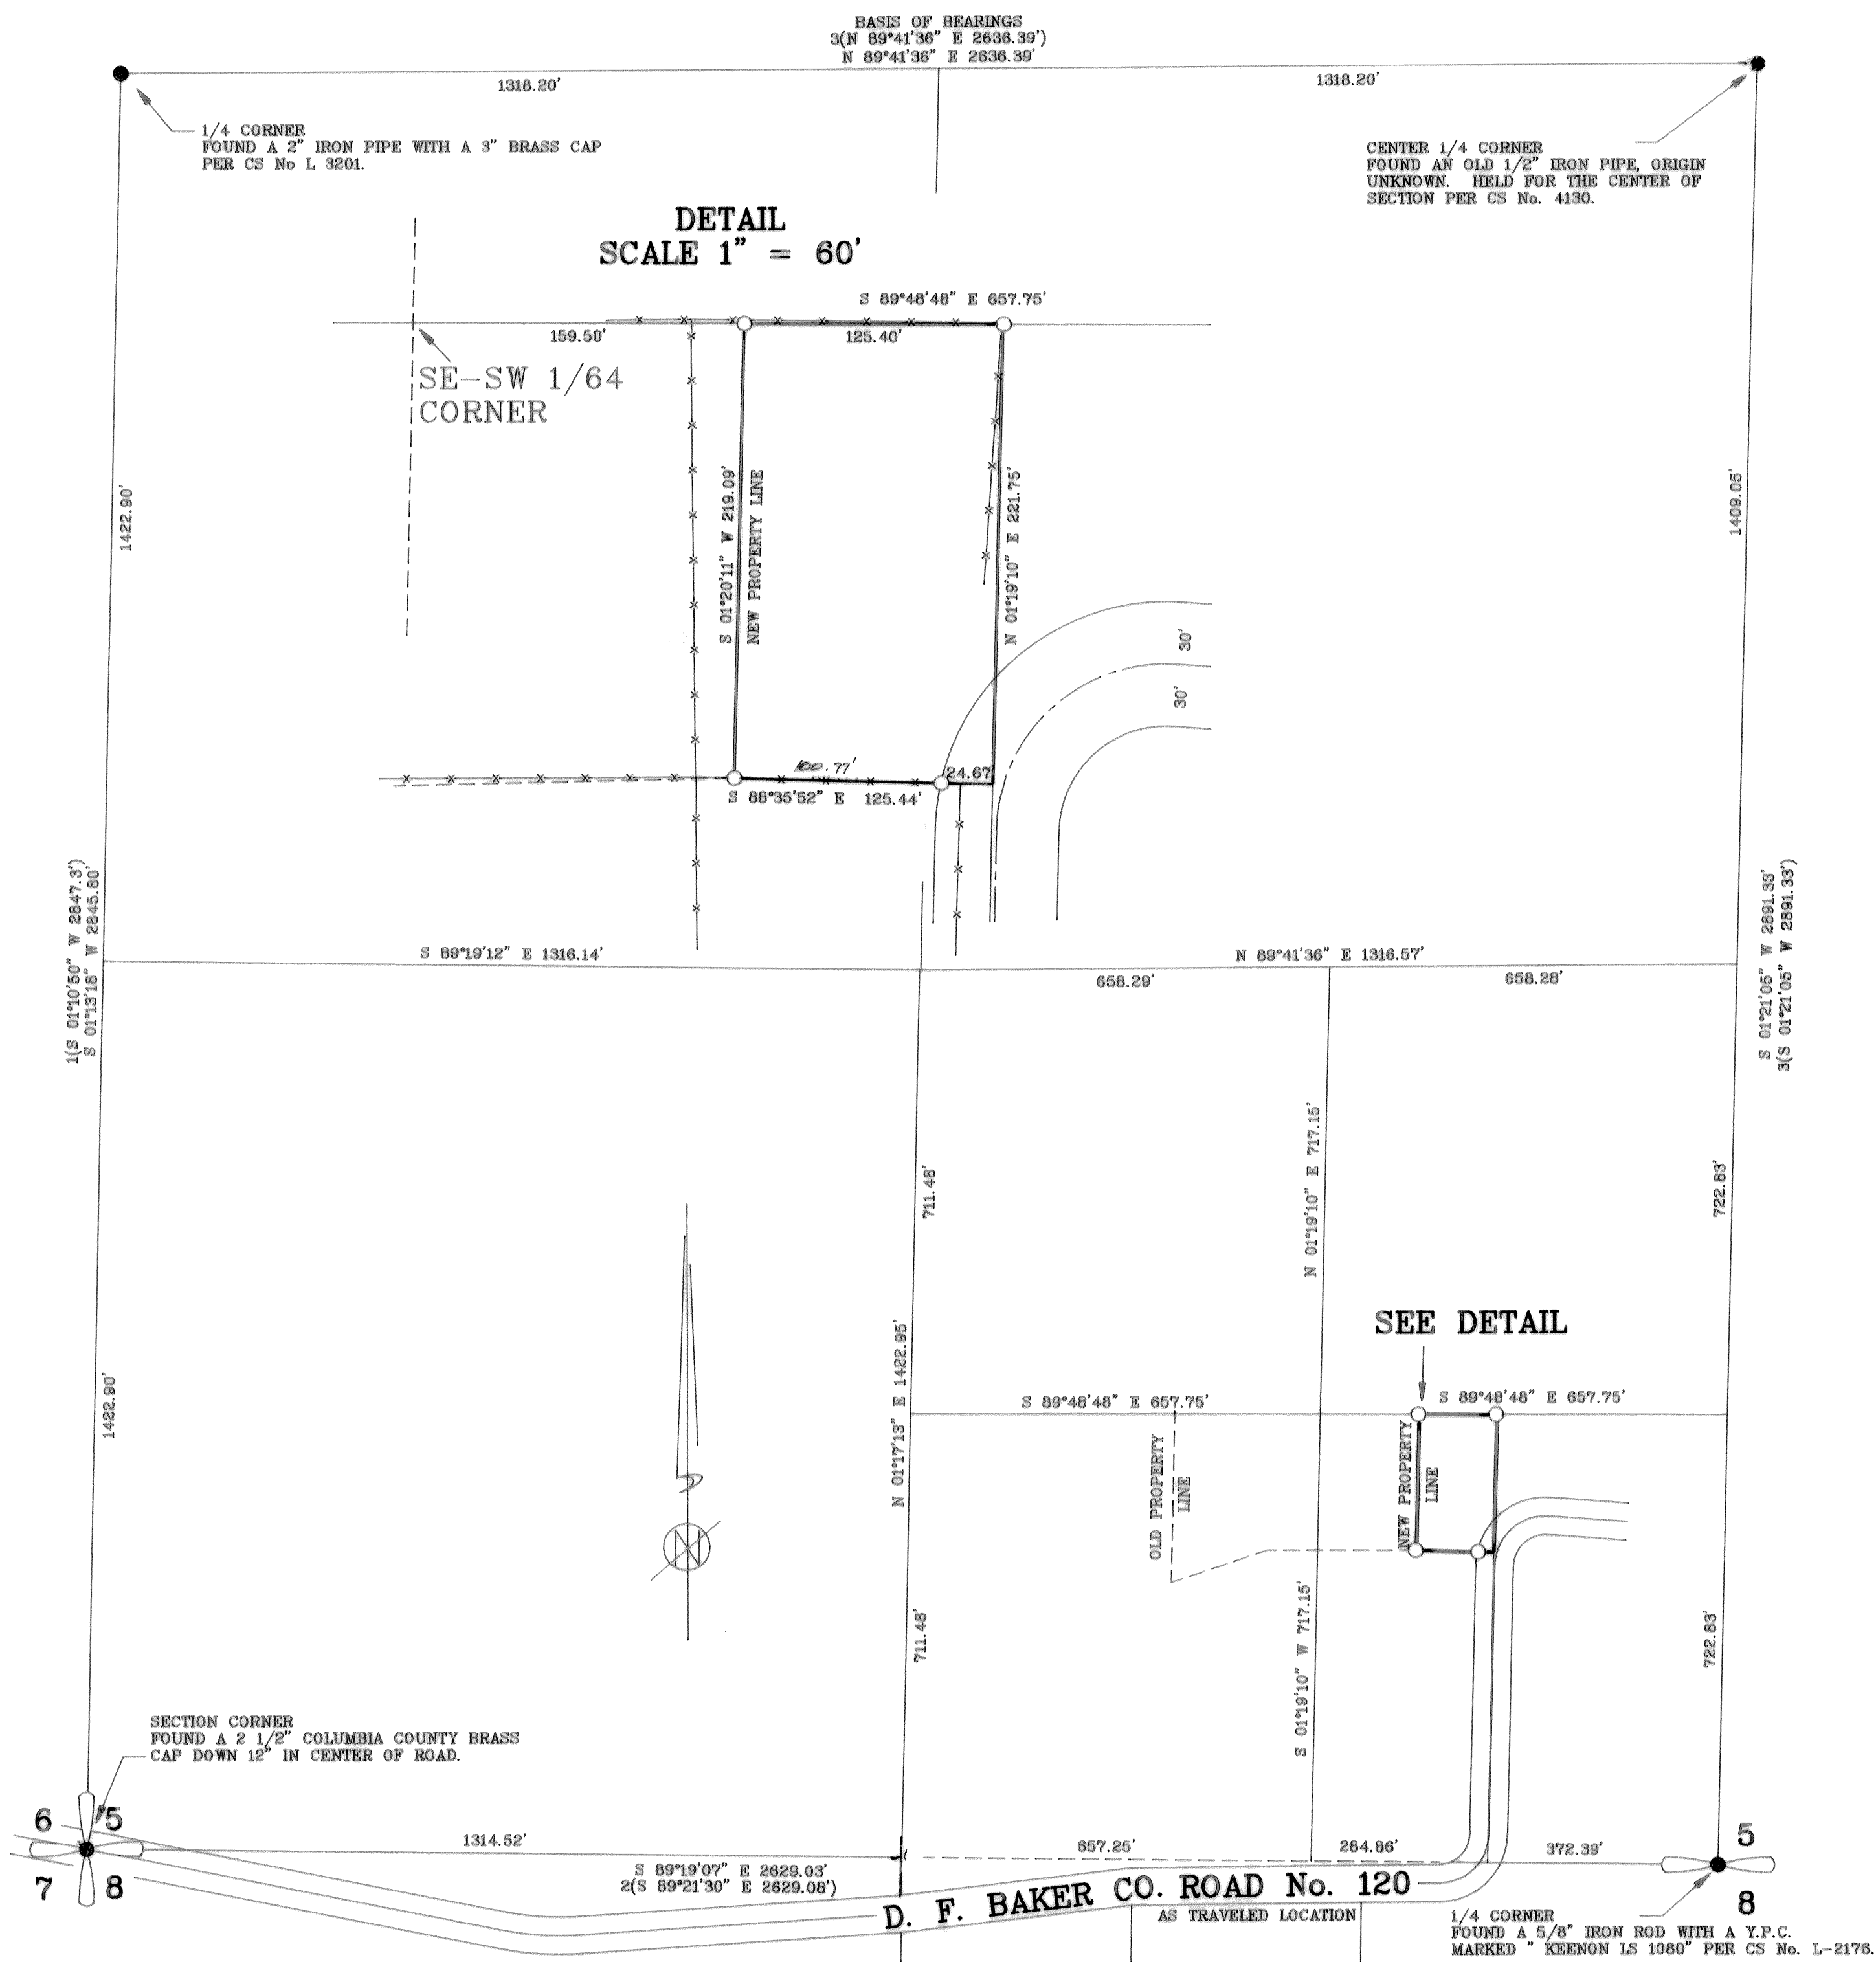


6005

5009

**NARRATIVE:**

--THIS SURVEY WAS ACCOMPLISHED AT THE REQUEST MAURICE BARSTAD TO MONUMENT A PROPERTY LINE ADJUSTMENT AS SHOWN.

--THE BASIS OF BEARINGS IS FROM CS No. 4130 BETWEEN THE CENTER OF SECTION AND THE SOUTH 1/4 CORNER.

--FOR THE SUBDIVISION OF THE SW 1/4 I HELD THE RECORD MONUMENTS AS NOTED, AT THE SW SECTION CORNER, THE CENTER OF SECTION, THE SOUTH 1/4, AND THE WEST 1/4 CORNER.

--THE NORTH LINE IS THE NORTH LINE OF THE SE 1/4 OF THE SE 1/4 OF THE SW 1/4. I ESTABLISHED THE NE CORNER OF THE SUBJECT TRACT AT THE DEEDED DISTANCE [284.9 FEET] FROM THE SE-SW 1/64 CORNER. I HELD THE EAST LINE PARALLEL TO THE WEST LINE OF THE SE 1/4 OF THE SE 1/4 OF THE SW 1/4 PER DEED CALLS. THE NEW SOUTH LINE WAS ESTABLISHED ALONG THE OLD FENCE LINE. THE NEW WEST LINE WAS ESTABLISHED AT THE LOCATION AS DETERMINED BY MR. BARSTAD.

LEGEND

- = MONUMENT FOUND AS NOTED
- = SET A 5/8" x 30" IRON ROD WITH A Y.P.C. MARKED "KEENON LAND SERVICES INC."
- () = RECORD SURVEY DATA
- [] = RECORD DEED DATA
- CS No. = RECORD SURVEY No.
- Y.P.C. = YELLOW PLASTIC CAP
- = CONTROL POINT No.

REFERENCE SURVEYS

- 1 = CS No. 3099
- 2 = CS No. 3709
- 3 = CS No. 4130

REGISTERED
PROFESSIONAL
LAND SURVEYOR

Leslie G. Keenon

OREGON
JULY 30, 1976
LESLIE G. KEENON
1080
RENEWAL DATE 6/30/99

KEENON LAND SERVICES

1224 ALDER ST.
VERNONIA, OR 97064
(503) 429-6115

PROPERTY LINE ADJUSTMENT FOR

MAURICE BARSTAD
IN THE SW 1/4 OF SECTION 5,
T4N, R4W, W.M.
COLUMBIA COUNTY, OREGON
SCALE 1" = 200' JUNE 4, 1999

COLUMBIA COUNTY
SURVEYORS OFFICE

RECEIVED
ACCEPTED 17-27-02
CHECK # _____

DRAWN BY: DDW

FIELD: DDW/th

EQUIPMENT: GTS300/TDS48

JOB No. 99-084A

PROJECT No. 95-099

REVISED: 6/7/99

6005

5009