4577

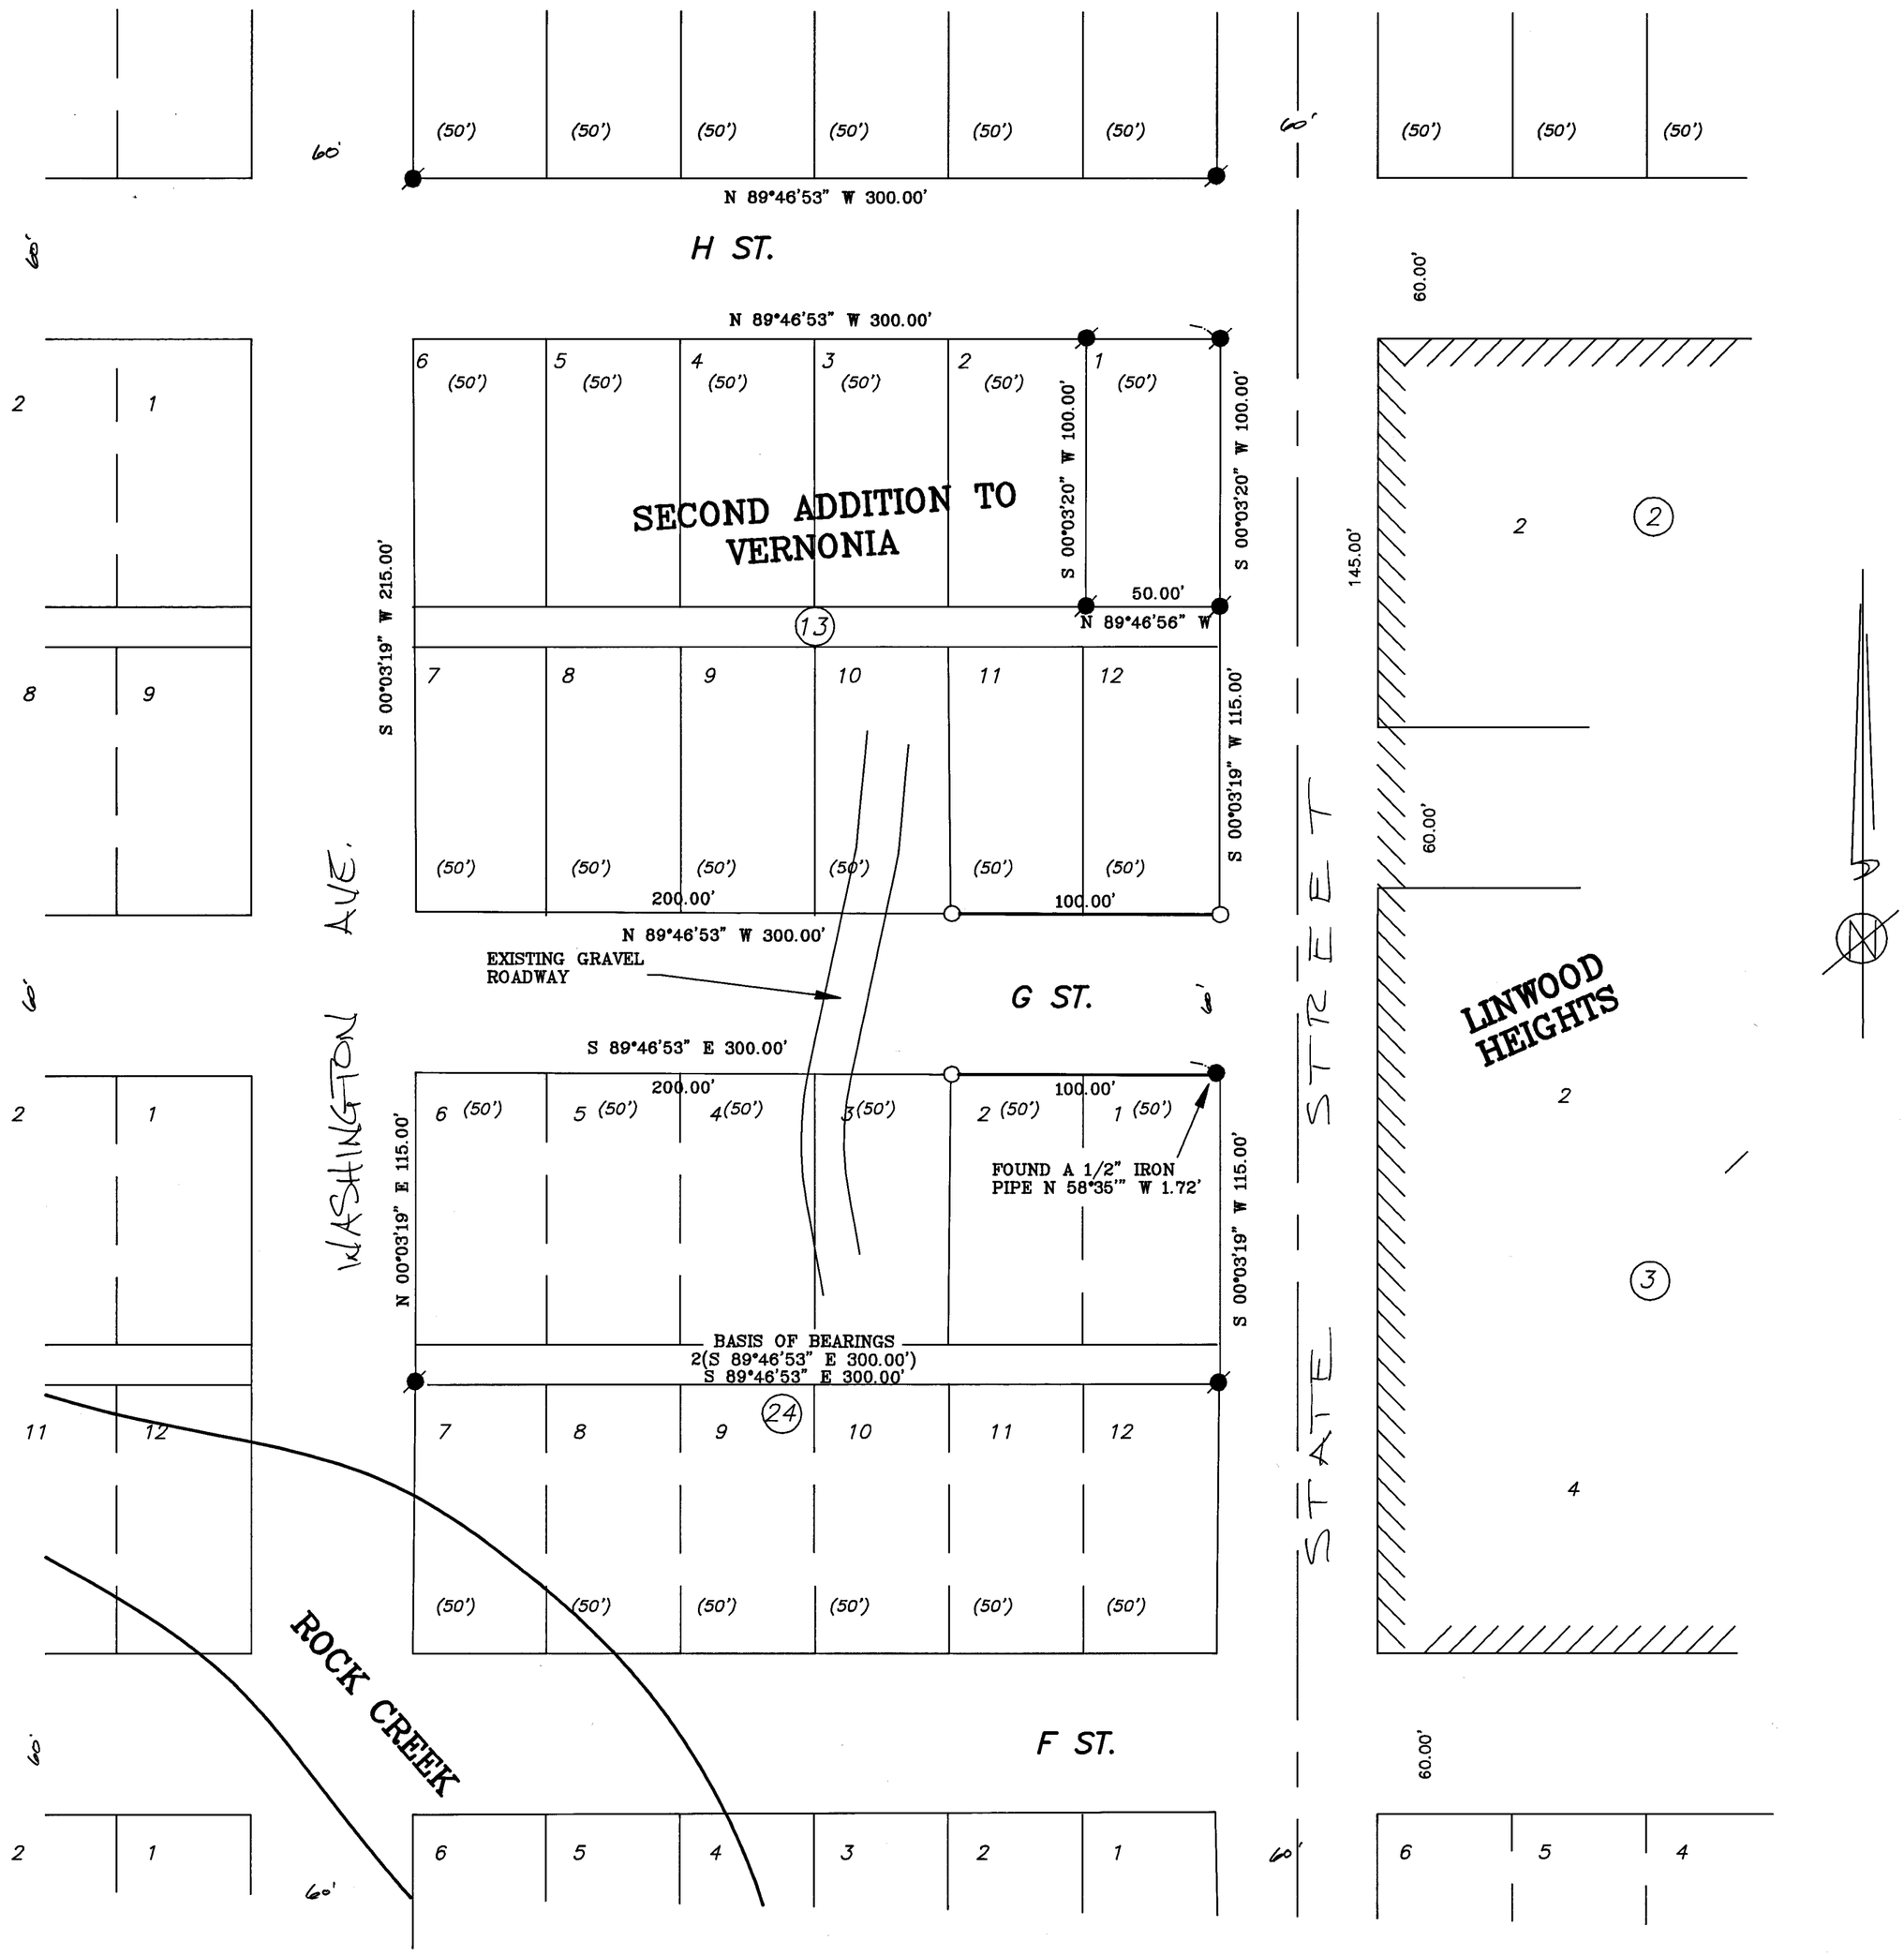

LEGEND

- ● = FOUND MONUMENT AS NOTED
- ⊘ = FOUND A 5/8" IRON ROD WITH A Y.P.C. MARKED "KEENON LAND SERVICES INC." PER CS No. 4322.
- ○ = SET A 5/8" x 30" IRON ROD WITH A Y.P.C. MARKED "KEENON LAND SERVICES INC."
- ( ) = RECORD SURVEY DATA
- [ ] = RECORD DEED DATA
- CS = RECORD SURVEY No.
- Y.P.C. = YELLOW PLASTIC CAP
- ⬭ = CONTROL POINT No.

NARRATIVE:

--THIS SURVEY WAS ACCOMPLISHED AT THE REQUEST OF THE CITY OF VERNONIA TO MONUMENT A PORTION OF G. STREET, SECOND ADDITION TO VERNONIA.

--THE BASIS OF BEARINGS IS FROM CS No. 4322.

-- FOR CONTROL I THE RECOVERED MONUMENTATION AND RECORD DATA PER CS No. 4322.

REFERENCE SURVEYS

1 = PLAT OF SECOND ADDITION
2 = CS No. 4322

REGISTERED PROFESSIONAL LAND SURVEYOR
OREGON
JULY 30, 1976
LESLIE G. KEENON
1080
RENEWAL DATE 6/30/99

KEENON LAND SERVICES
1224 ALDER ST.
VERNONIA, OR 97064
(503) 429-6115

SURVEY FOR
THE CITY OF VERNONIA
IN SECOND ADDITION TO VERNONIA
IN THE NW 1/4 OF SECTION 4,
T4N, R4W, W.M.
COLUMBIA COUNTY, OREGON
SCALE 1" = 50' NOV 2, 1998

COLUMBIA COUNTY SURVEYORS OFFICE
RECEIVED 12-3-98
ACCEPTED 3-3-99
CHECK # 314

DRAWN BY: DDW | FIELD: DDW/RH | EQUIPMENT: GTS300/TDS48 | JOB No. 98-148 | PROJECT No. 96-102 | REVISED: 11/14/98

4577

4577